


LOT 3 ALANCE BROWN'S SUB. OF E. 1/2 OF BLK. 13
OSTINSON BROWN & PARTSEY'S ADD.
Sur. Map. 30. 1003 For Final Notating

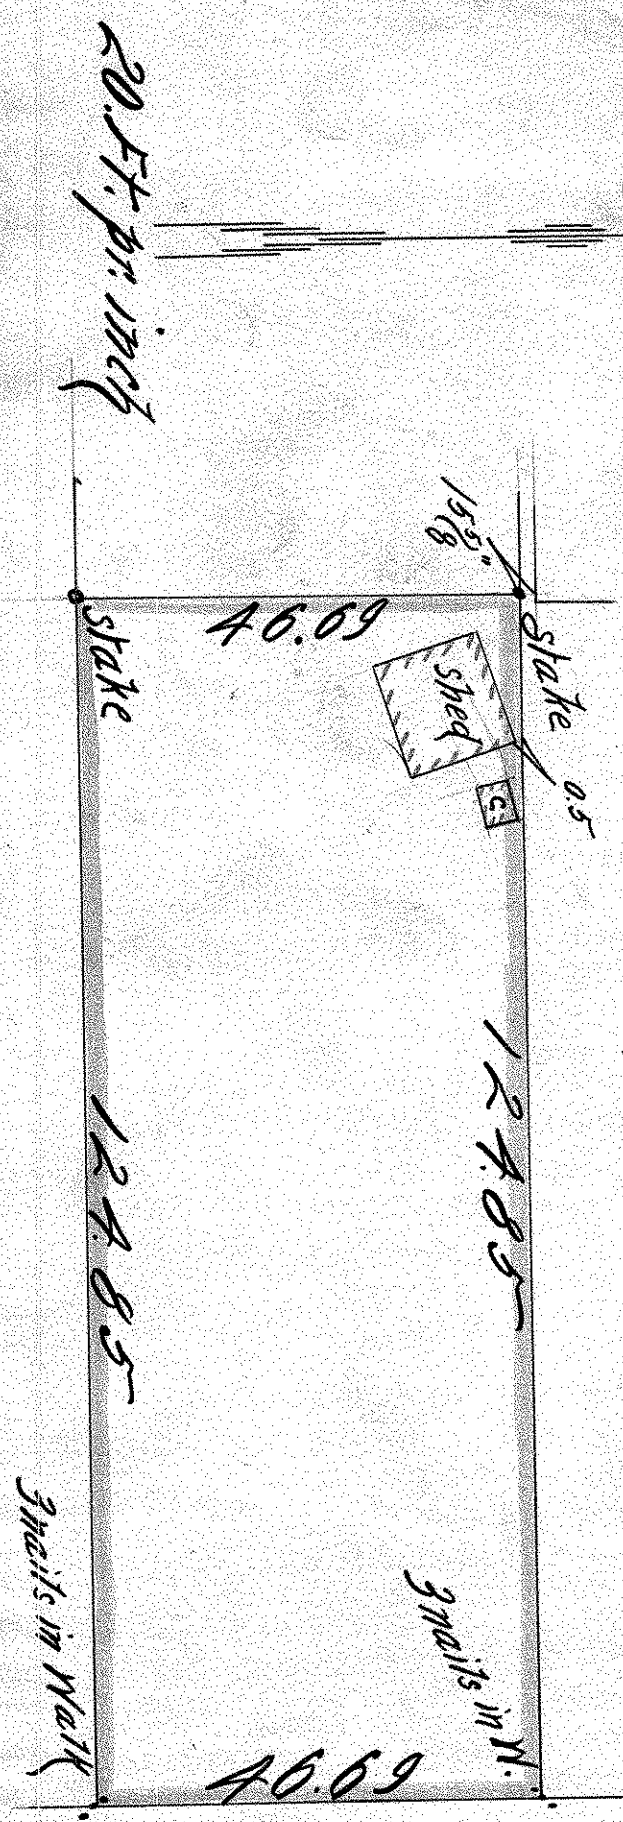

DUKE ST.
D. 53. P 77