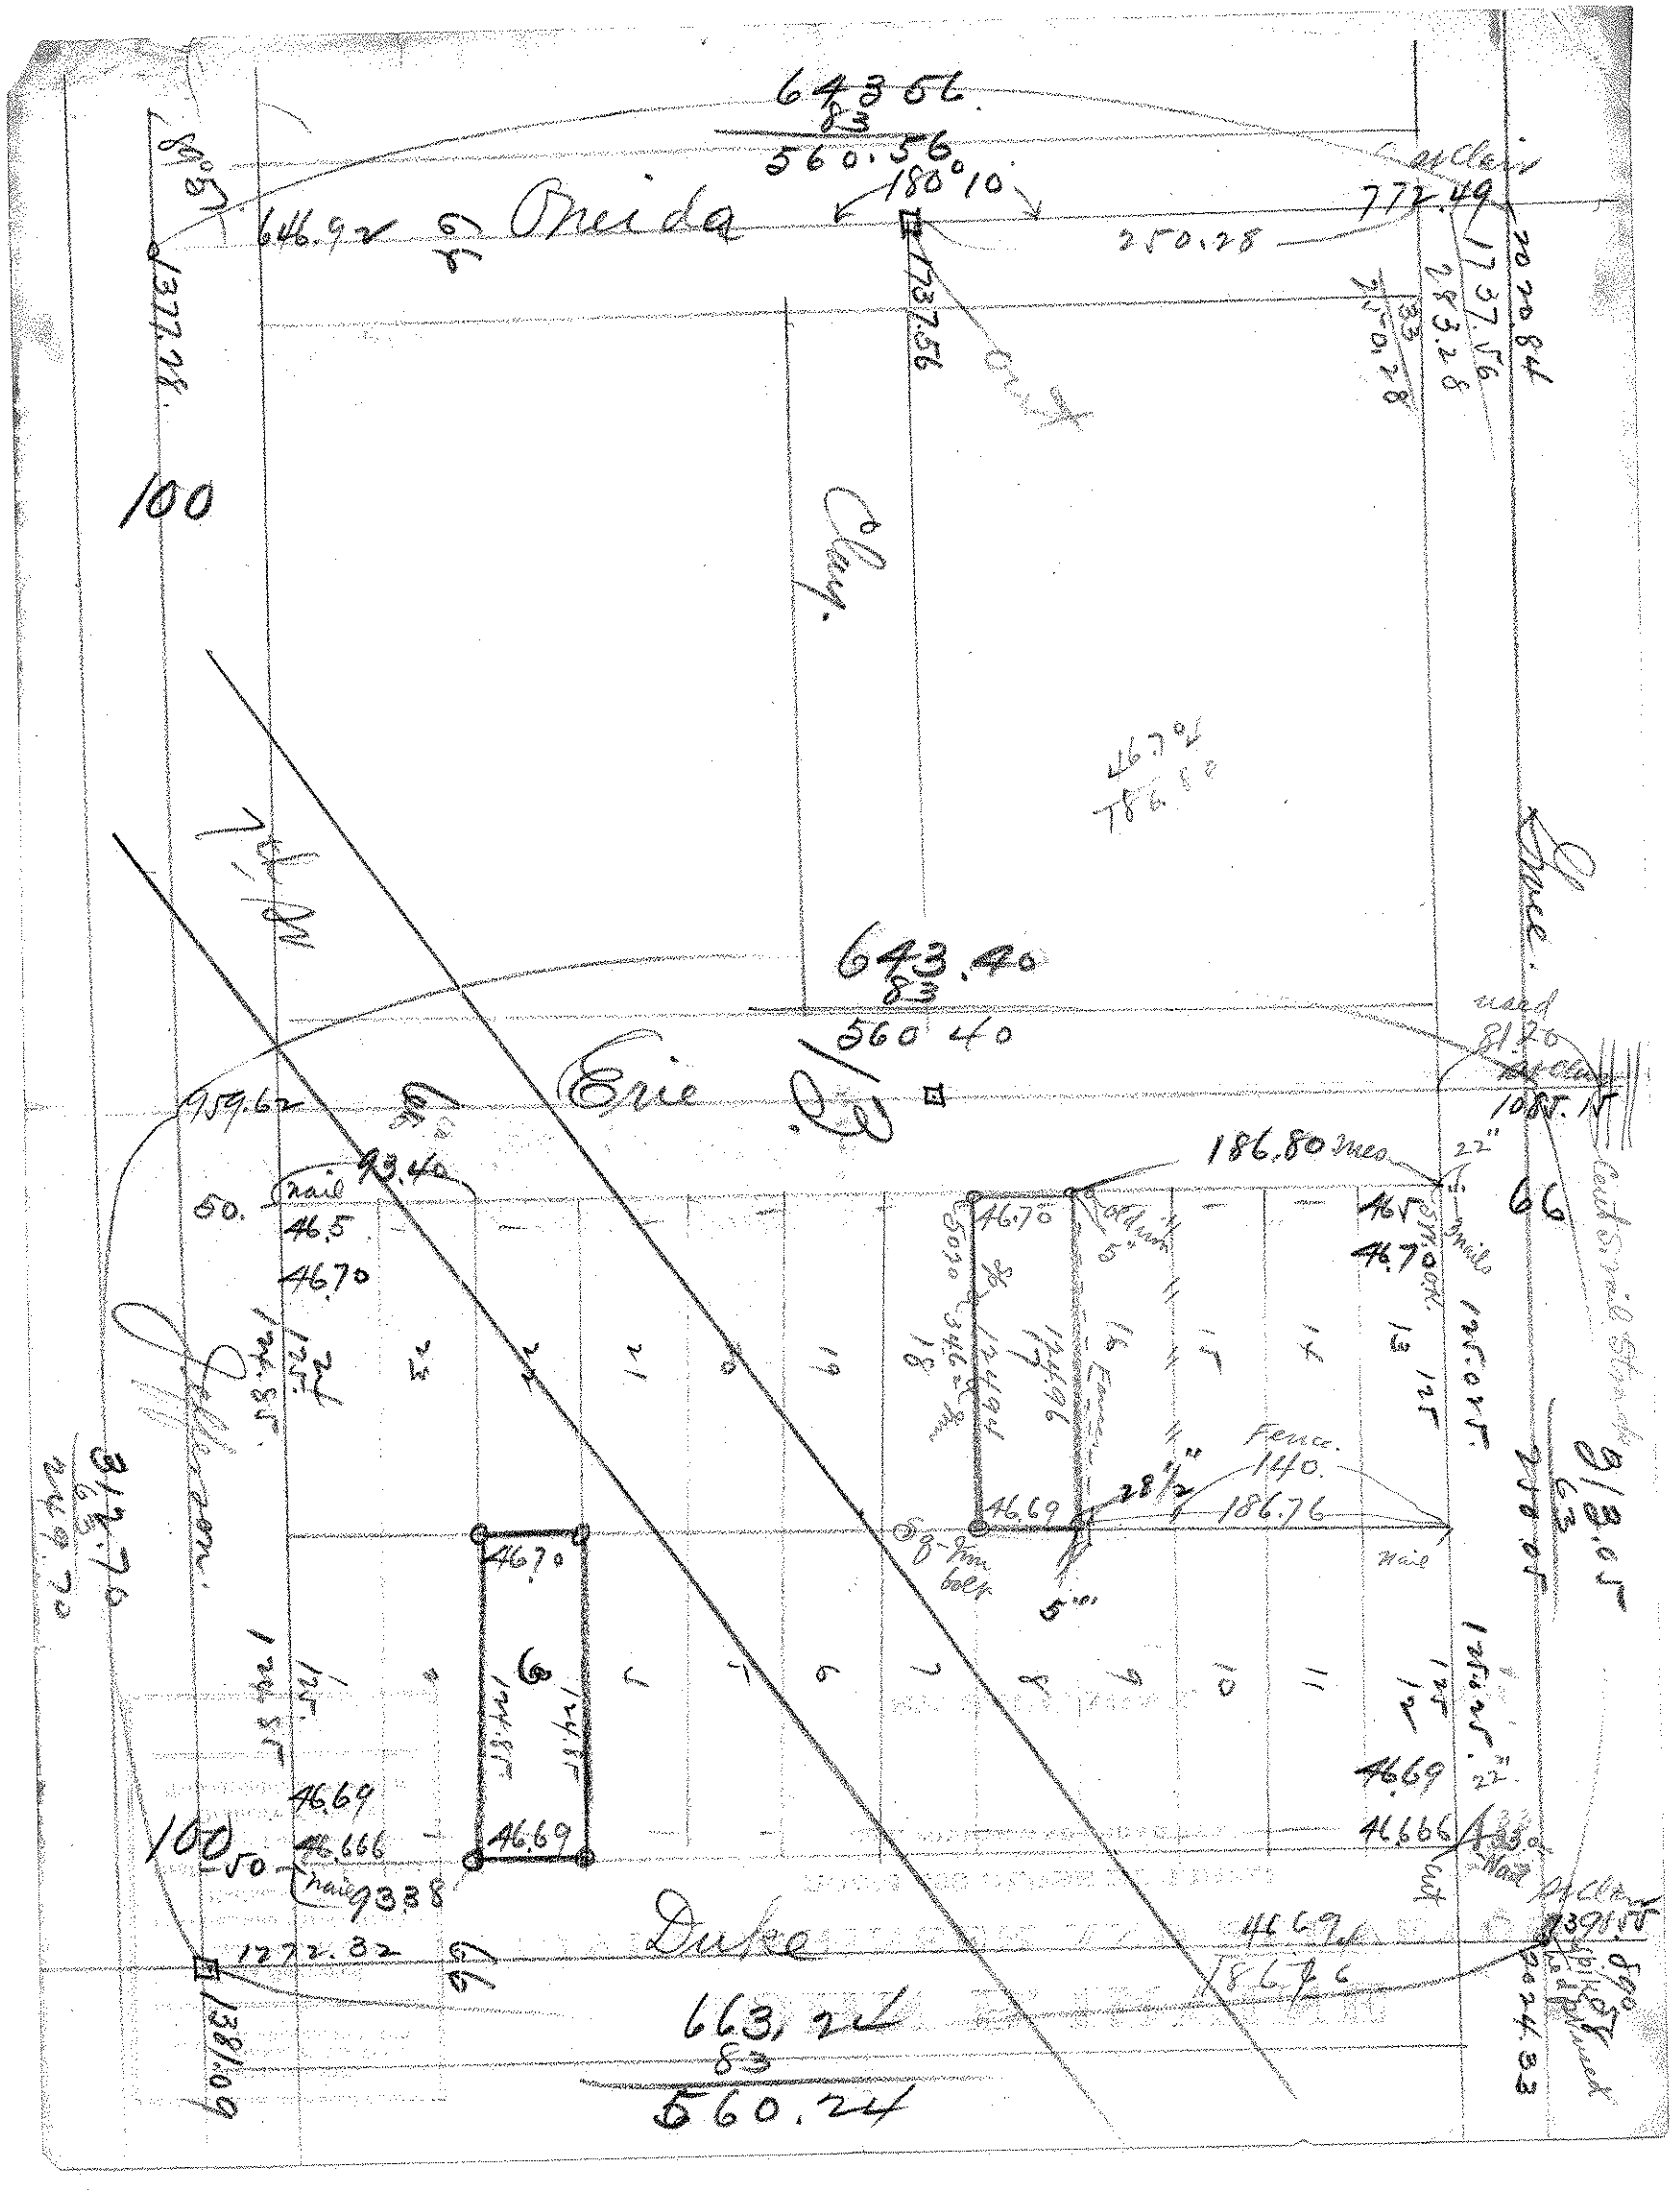

643.56
83
560.56
180°10'
646.92
Oneida
772.49
250.28
1737.56
100
Clay
643.40
83
560.40
Erie
959.62
93.40
186.80 mes
46.70
46.69
Fence
140.
186.76
46.666
93.38
1272.32
Duke
663.24
83
560.24
1381.09
1085.15