


Lot 34 A. Vance ✓
Brown's sub ~~23~~

Stinson, B + Ramsays
Geo. Schreiner

330 Daly Collect
Aug 16-05

Mont

1757.04 Rand + View Mt.
1157.22 C R + Bay
Mont N.E. Palace + Diet.
" S.E. Palace + Marsano
" S.E. James + Diet
" N.E. " + Marsano
C Grace + View 1914.38
C " + Bay 1281.92

 

1914