

cut No.

Mont 33


Jefferson

100

449.65 mes  
444.97

45	125	125	449.65 mes
-	11	10	444.97
-	12	9	
-	13	8	
-	14	7	
-	15	6	
-	16	5	
-	17	4	
-	18	3	
-	19	2	
45	20	1	
10	125	125	

19

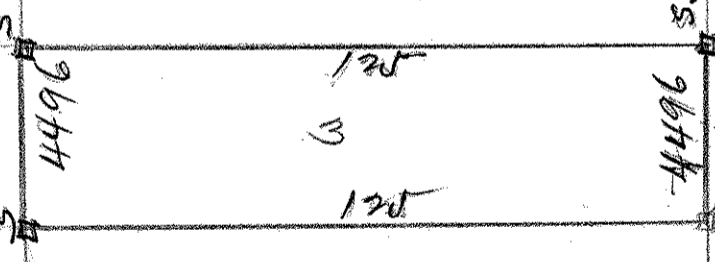

250.60 mes bed wks

66 Palace

449.65 mes  
444.97

449.65 mes on Pealy but wks

444.97  
mont ne cor.  
Victoria

6633  
33  
mon