


LOT 5 BLOCK 1
BRYANT'S ADD.
SUT. July 29th 1902
20 ft. pr inch

LAUREL AVE.

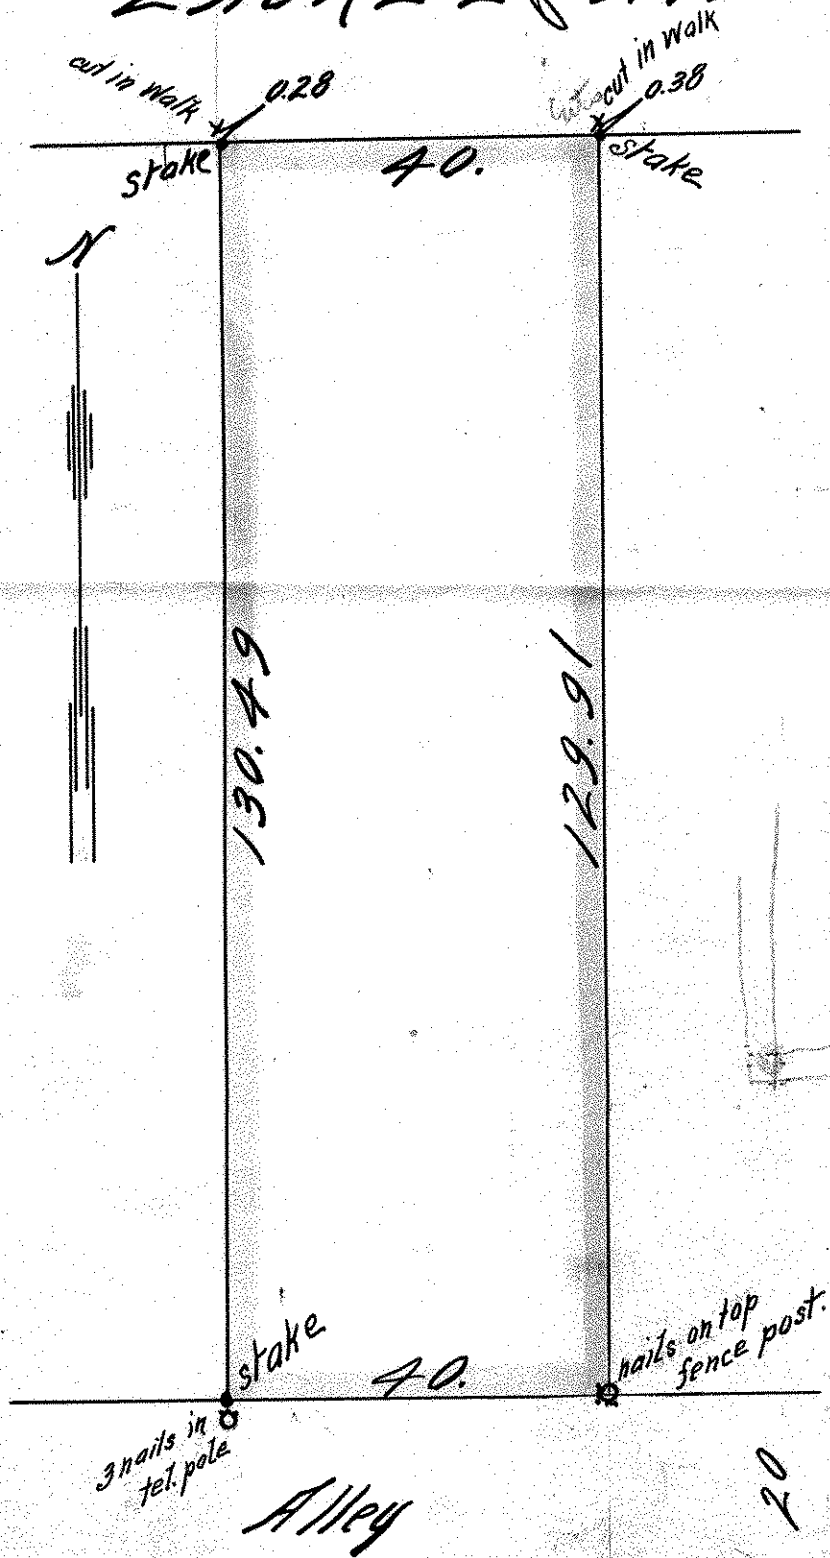

B47. P56.