

LOT 26 BLOCK 2
BRYANT'S ADD.



JOHN B. IRVINE, SURVEYOR.

ST PAUL MINN.

DEC. 4-1908.

SCALE, 20ft per inch.

ALLEY, 20

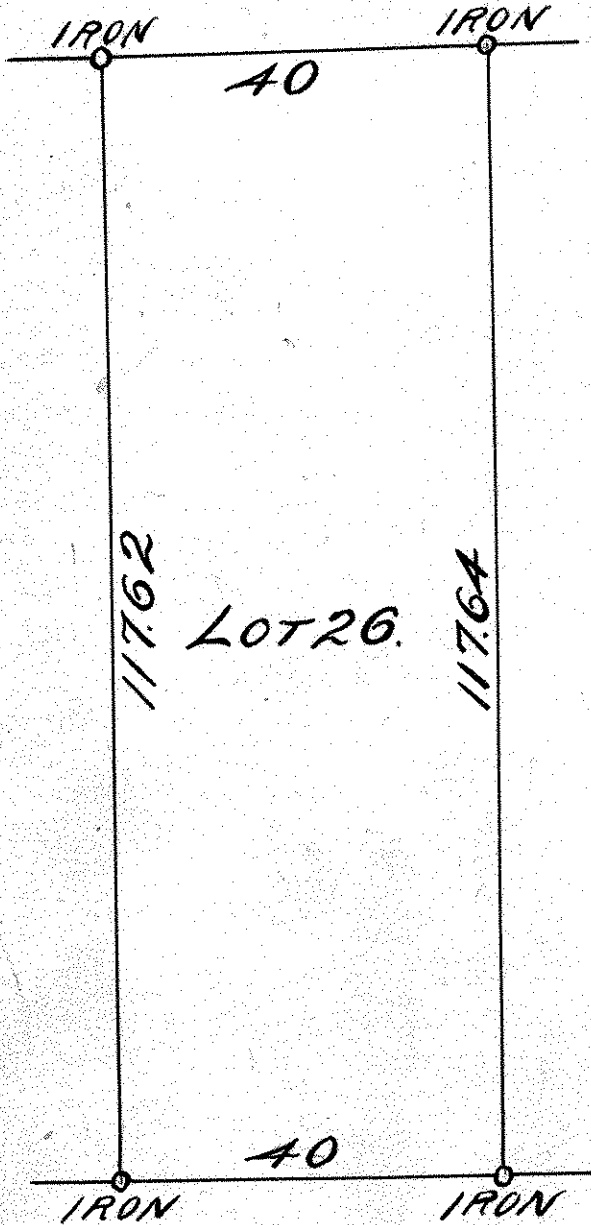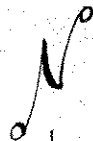

HOLLY AVE.