


N
 SOUTH 50ft. LOTS 1, 2 & 3. BLOCK 2
 BRYANT PARK ADD. No. 4.

JOHN B. IRVINE, SURVEYOR.
 ST. PAUL MINN.
 MARCH 18-1908

SCALE 20ft. per inch. OSCEOLA AVE

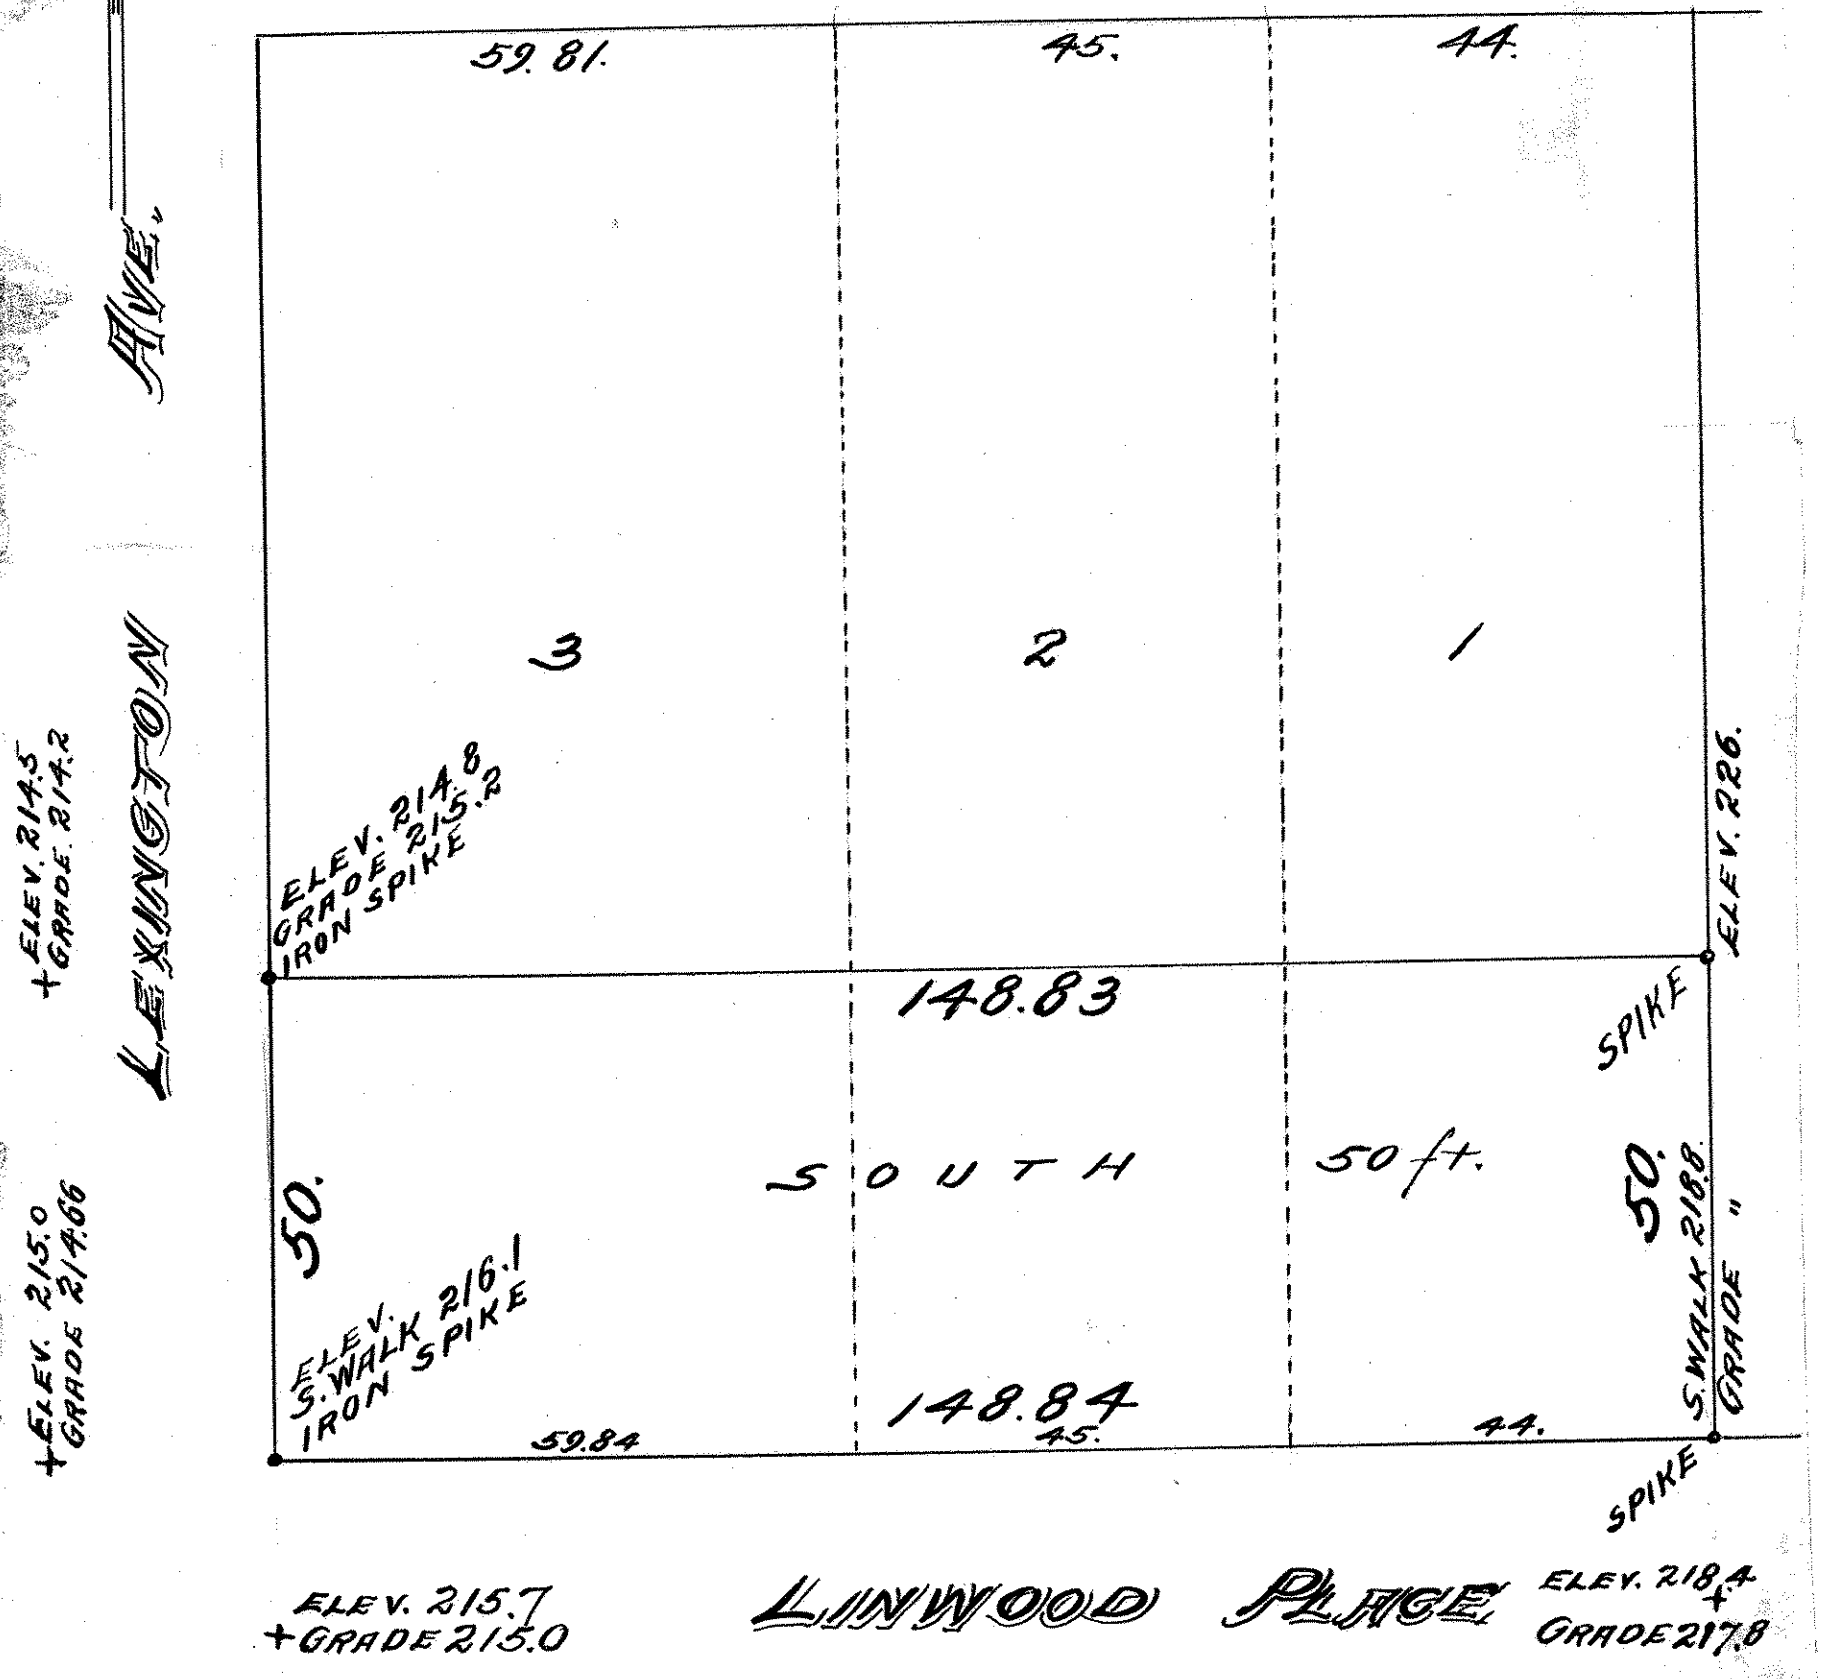

ELEV. 214.5
 + GRADE 214.2

ELEV. 215.0
 + GRADE 214.66

ELEV. 214.8
 GRADE 215.2
 IRON SPIKE

ELEV. 216.1
 S. WALK SPIKE
 IRON SPIKE

ELEV. 226.
 SPIKE

50.
 S. WALK 2188.
 GRADE "

SPIKE

ELEV. 215.7
 + GRADE 215.0

LINWOOD PLACE ELEV. 218.4
 + GRADE 217.8