# LOT 13 BLOCK 2.

# BRYANT'S PARK ADD. No. 3.

JOHN B. IRVINE, SURVEYOR.
408 GLOBE BLD'G.
ST. PAUL, MINN.
NOV. 29-1911.
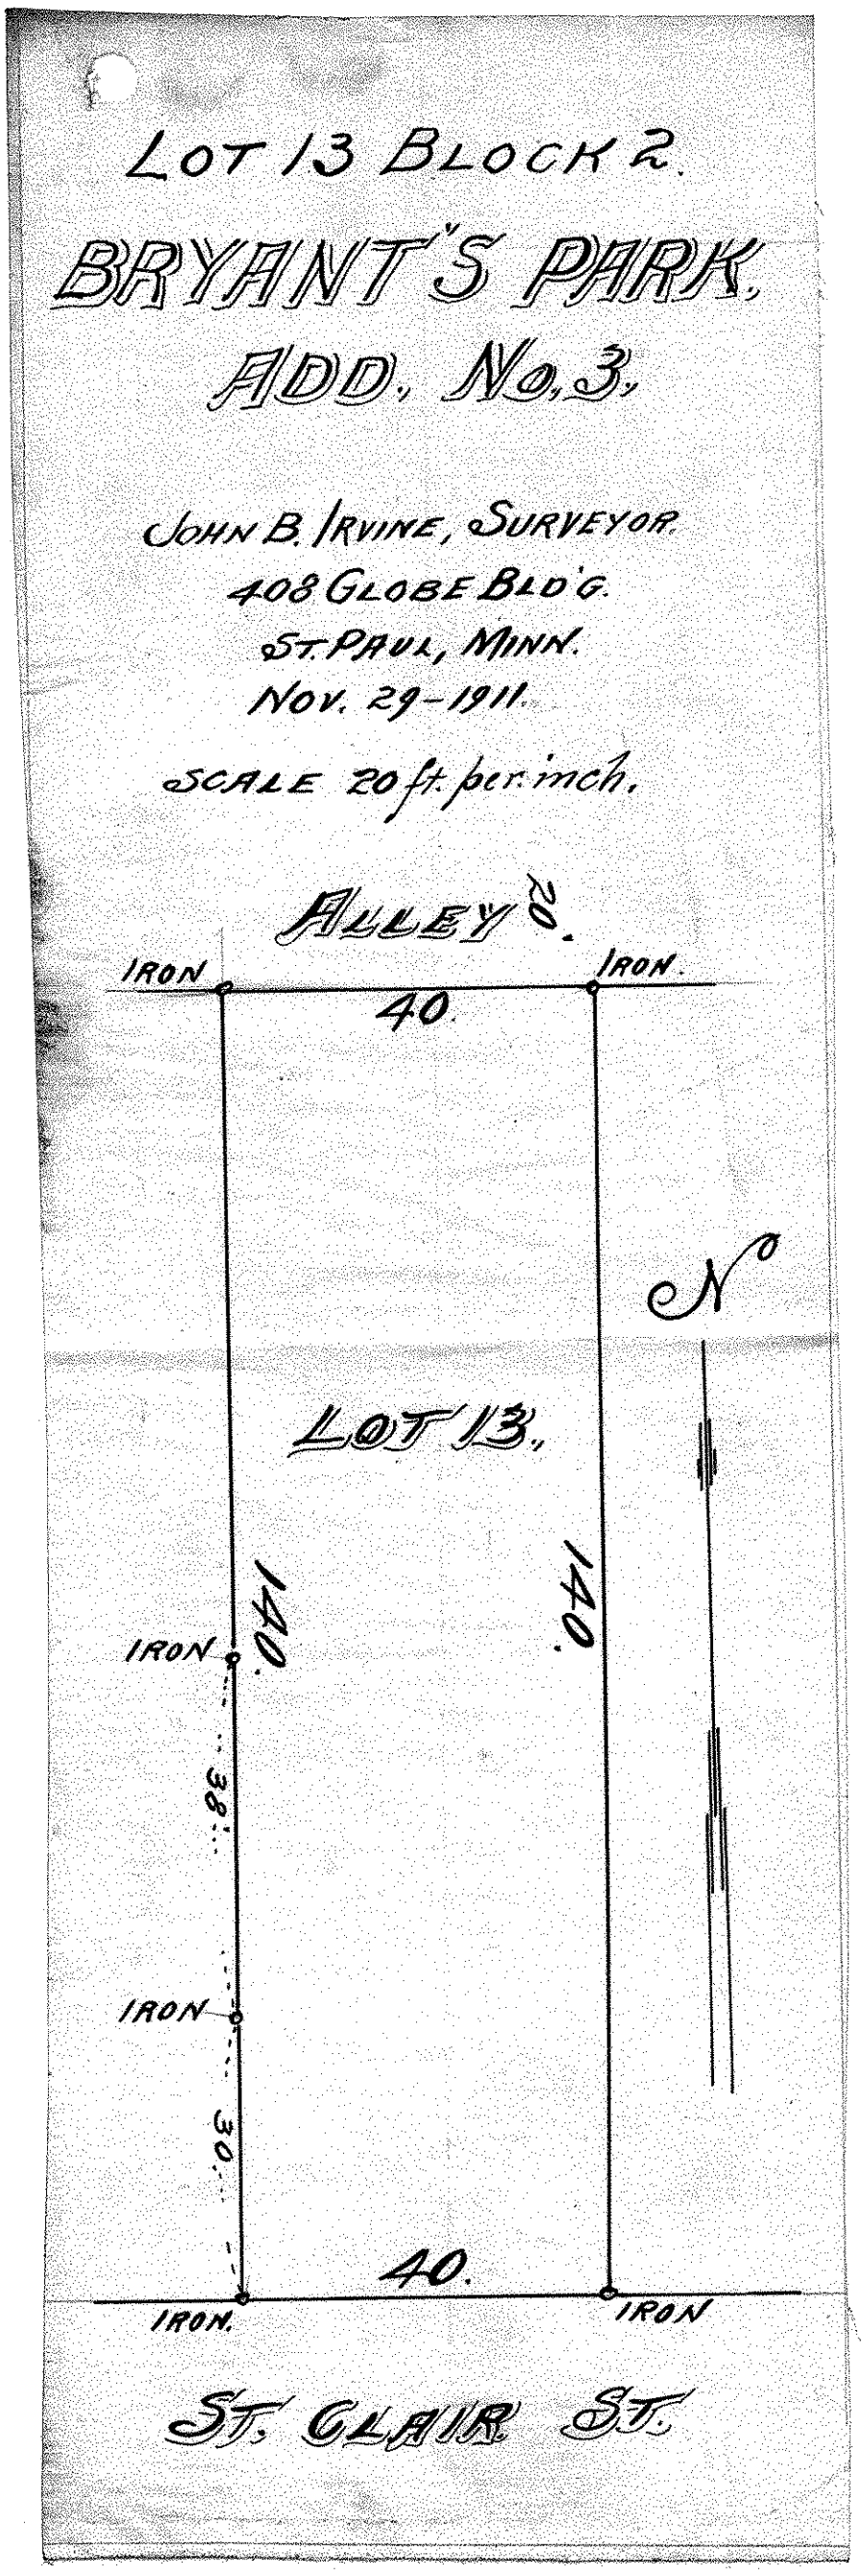
SCALE 20 ft. per inch.