FROM THE OFFICE OF

## Certificate of Survey

Project No. Minn A-1-7

Porcel No. 171-D

Area. 4840 Sq.H., m.o. L.

Description:

Lot 23,
Block I,
Byrants Randolph St. Addition
Ramsey County,
Minnesota.

## CHARLES O. GEORGI COMPANY

2215 West County Road B

Saint Paul, Minnesota 55113

REGISTERED CIVIL ENGINEER AND LAND SURVEYOR


I Hereby Certify that this plat shows a survey made by me of the property described on this plat, and that the corners are correctly placed as shown, and that all locations have been correctly shown.

Surveyed For Housing Authority

Date February 1974

Scale 1 = 40

REGISTERED LAND SURVEYOR

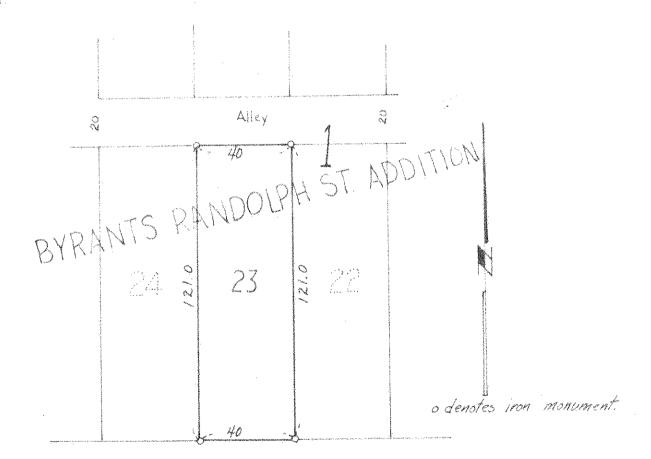

JUNO AVE.