


80-68-8

Belmont

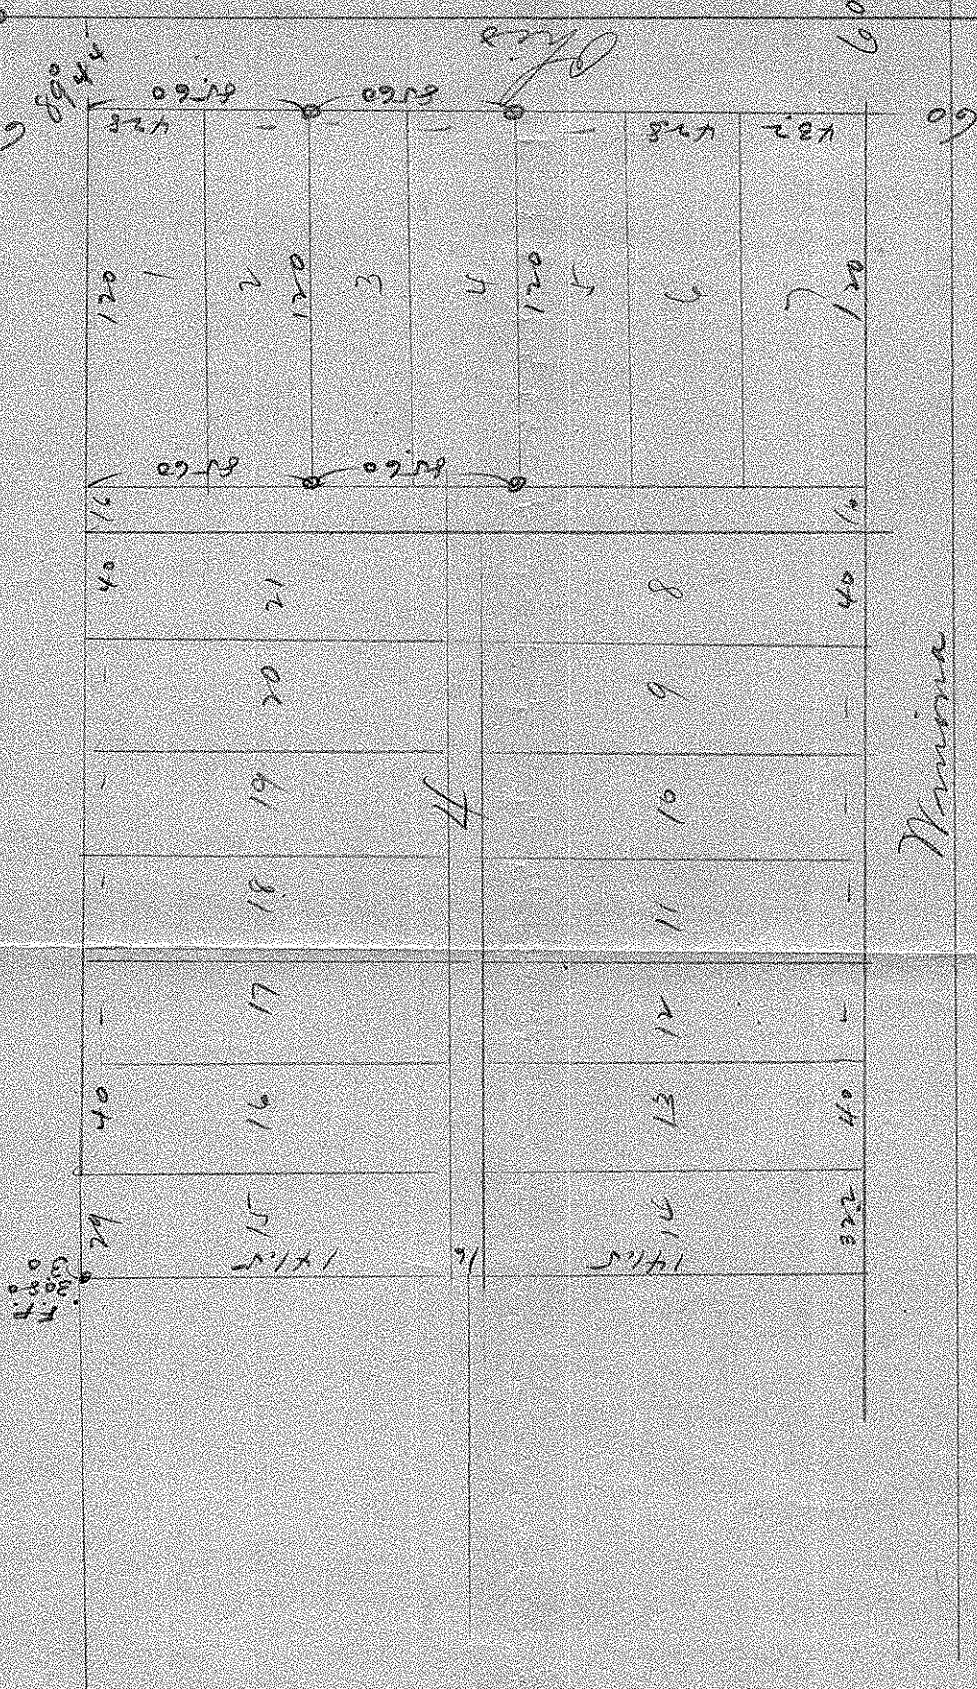

Winnona