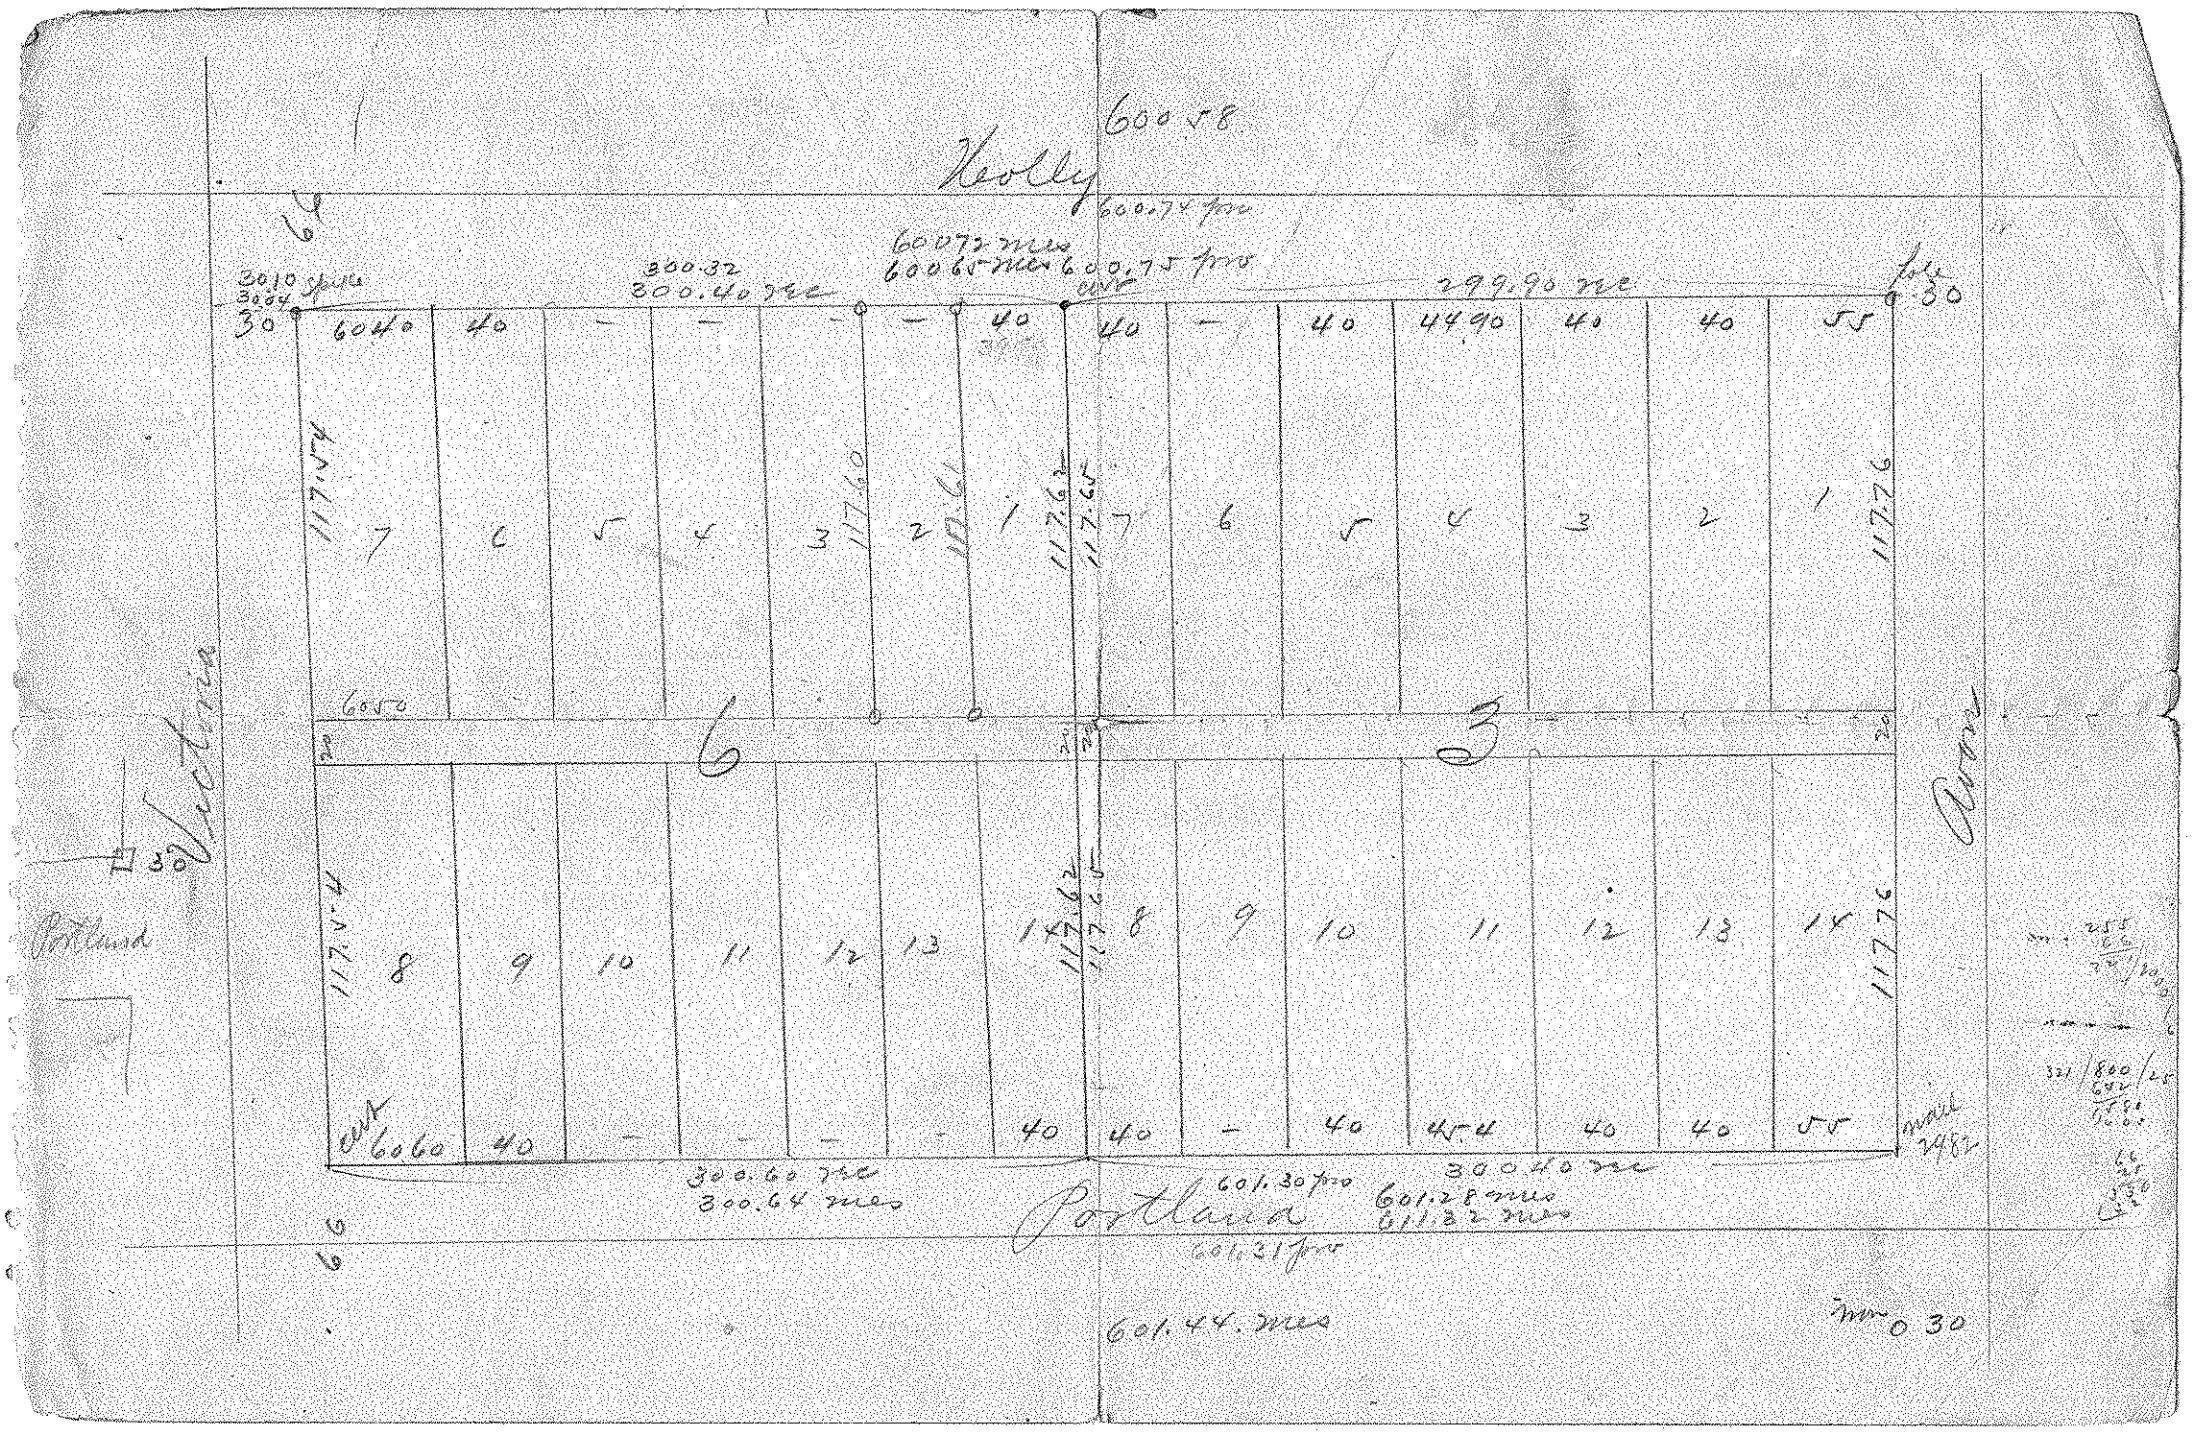

600 58
Holly
600.74 pro
600.72 mes
600.65 mes 600.75 pro
300.32
300.40 rec
299.90 rec
3010 spike
3004
30
6040
40
40
44.90
40
40
55
117.54
7
6
5
4
3
117.60
2
117.61
1
117.62
117.65
7
6
5
4
3
2
1
117.76
6050
6
3
Victoria
Avon
Portland
117.54
8
9
10
11
12
13
14
117.62
117.65
8
9
10
11
12
13
14
117.76
6060
40
40
40
45.4
40
40
55
300.60 rec
300.64 mes
601.30 pro
300.40 rec
601.28 mes
611.32 mes
Portland
601.31 pro
601.44 mes