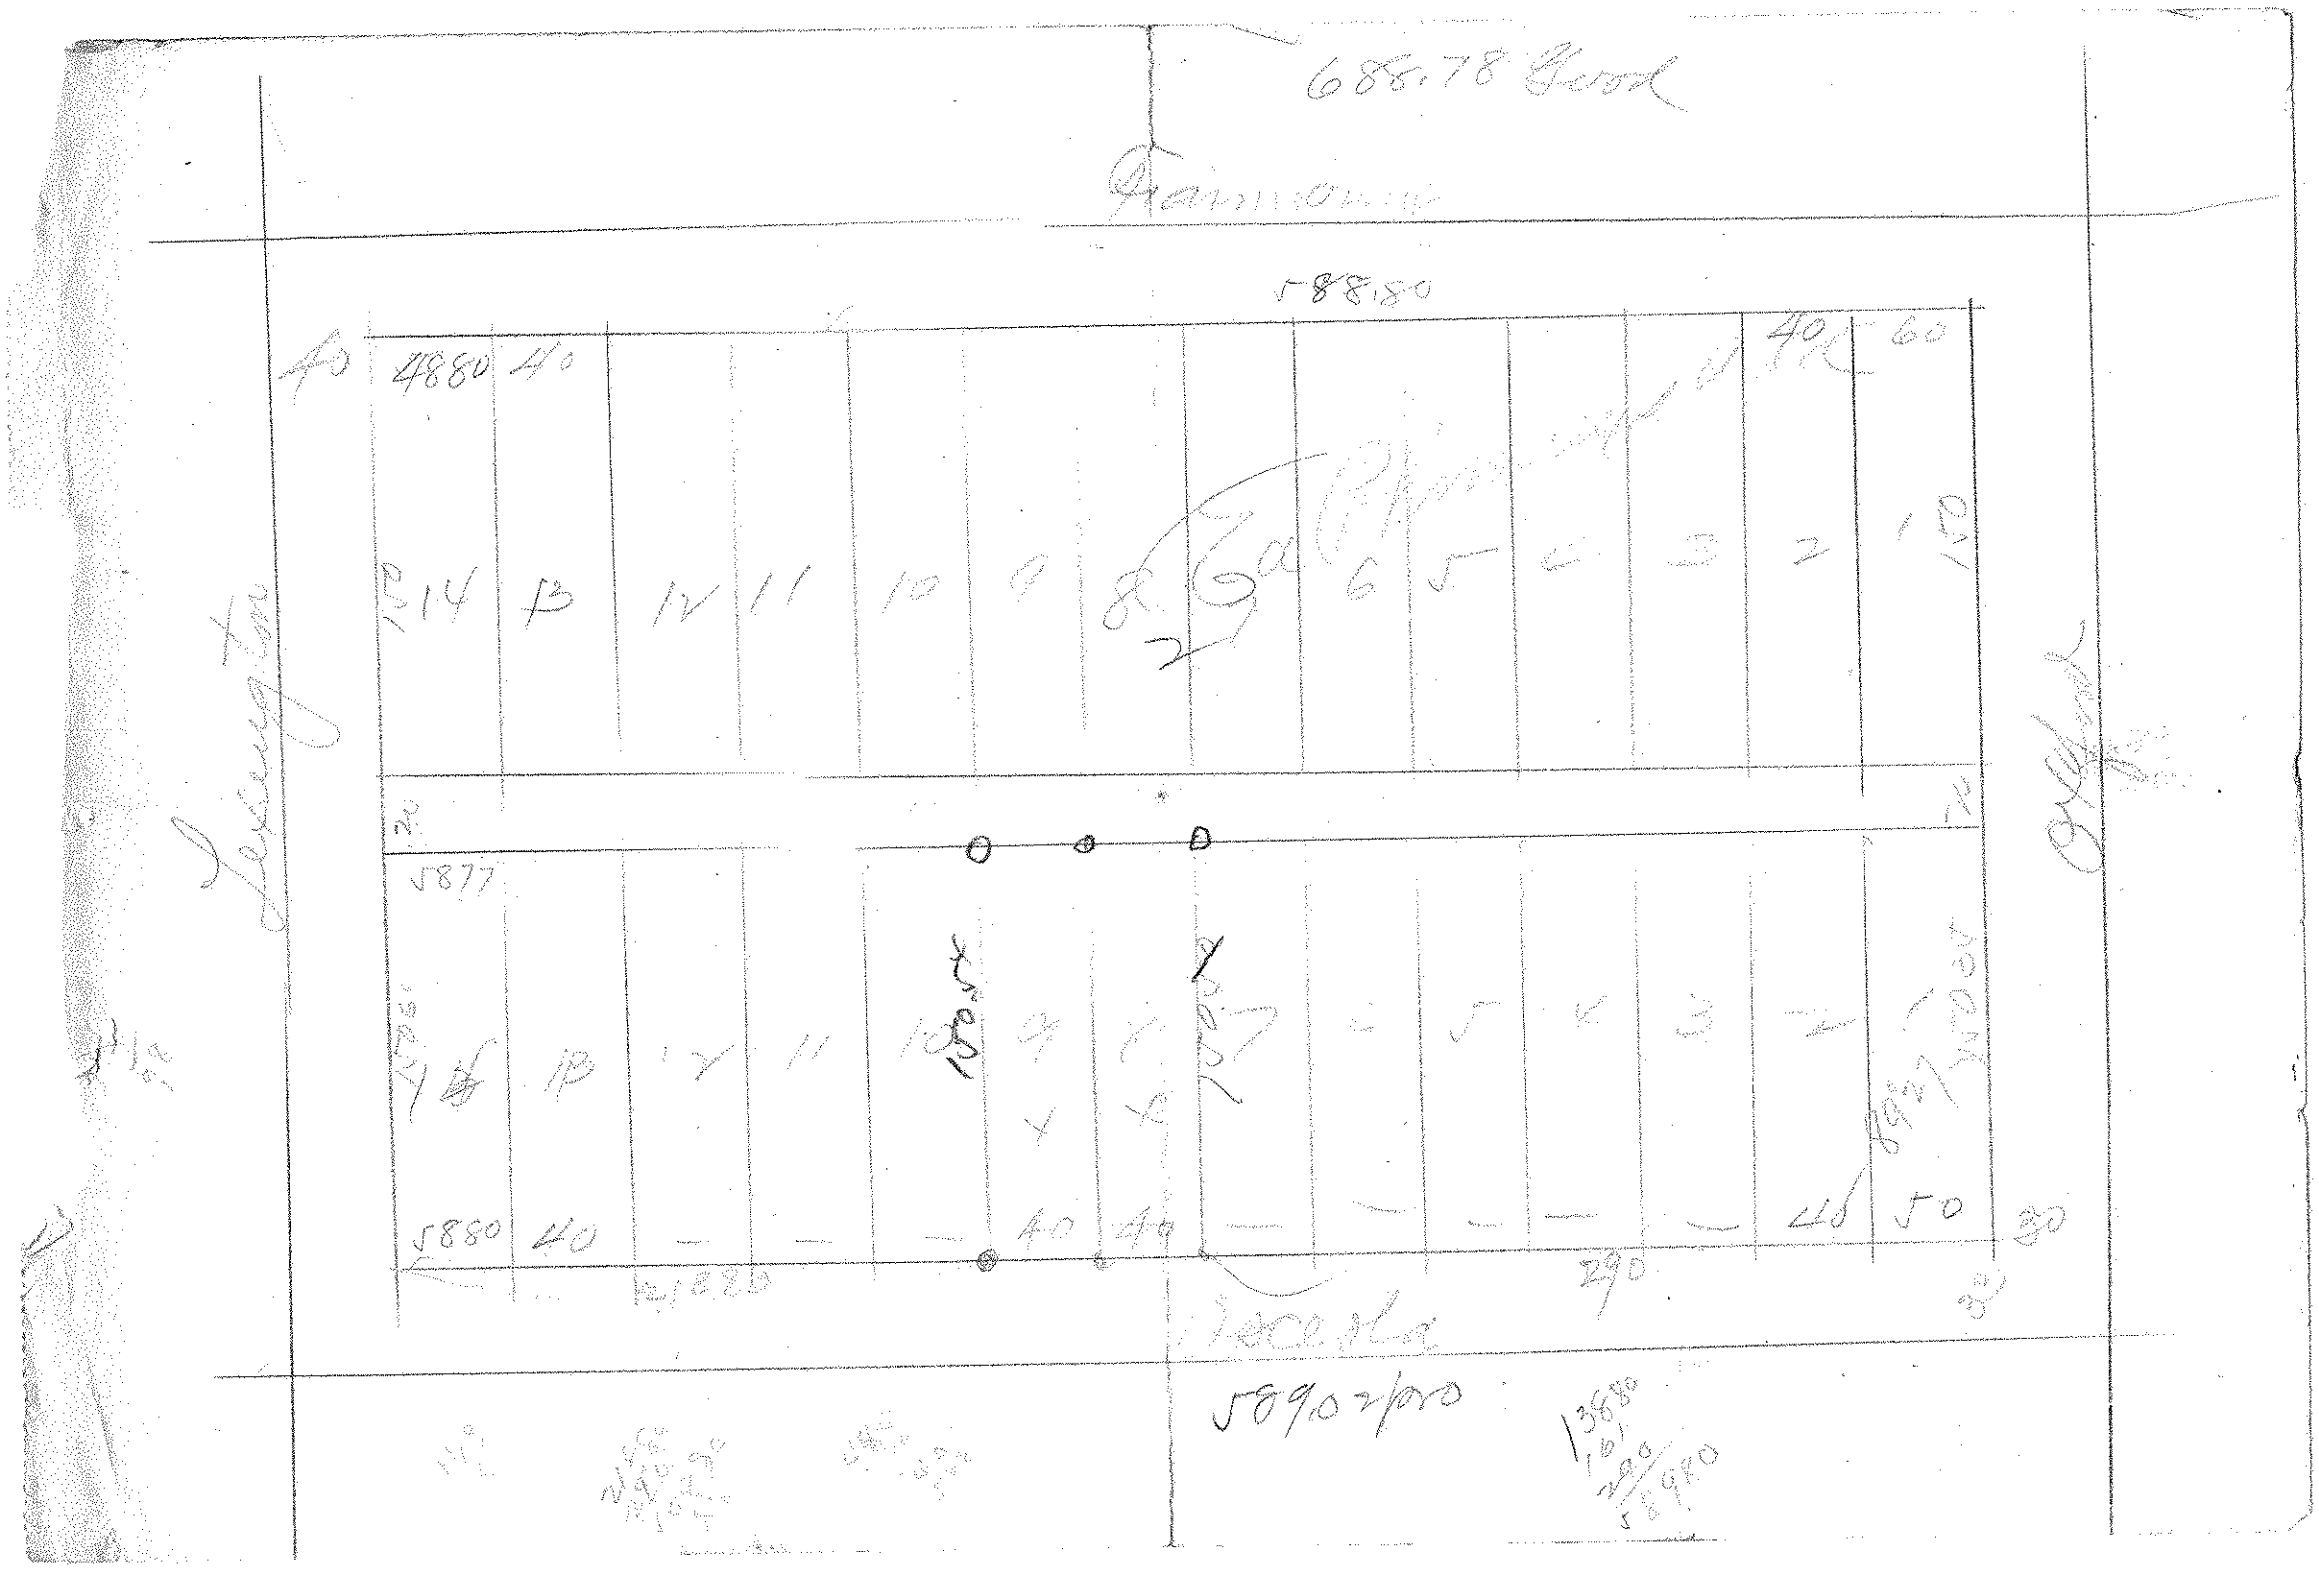

688.78 Good
588.80
4880
5877
5880
Lexington
Osceola
5890 2/20