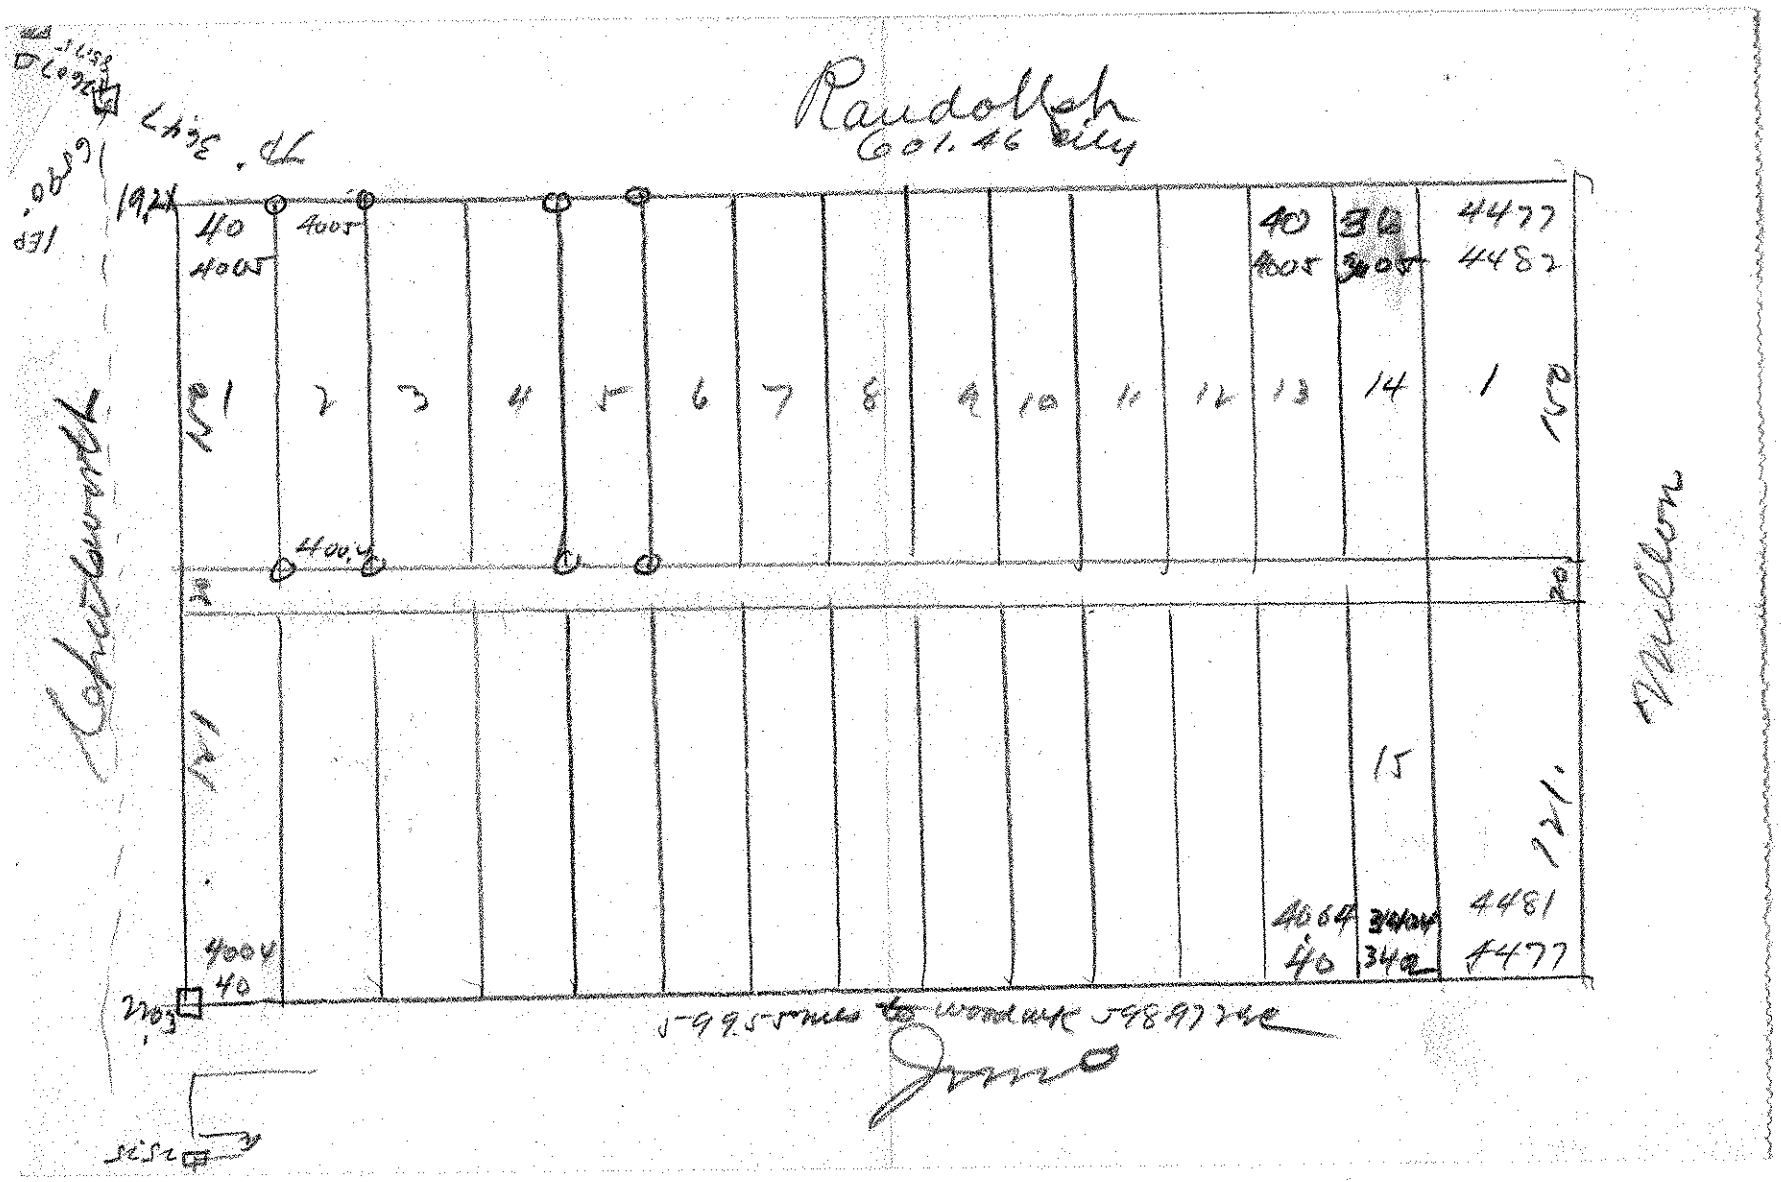
Randolph
Col. 46 City
Columbus
Madison
1924
40
400'
4477
4482
4481
15
1211
1211
1211