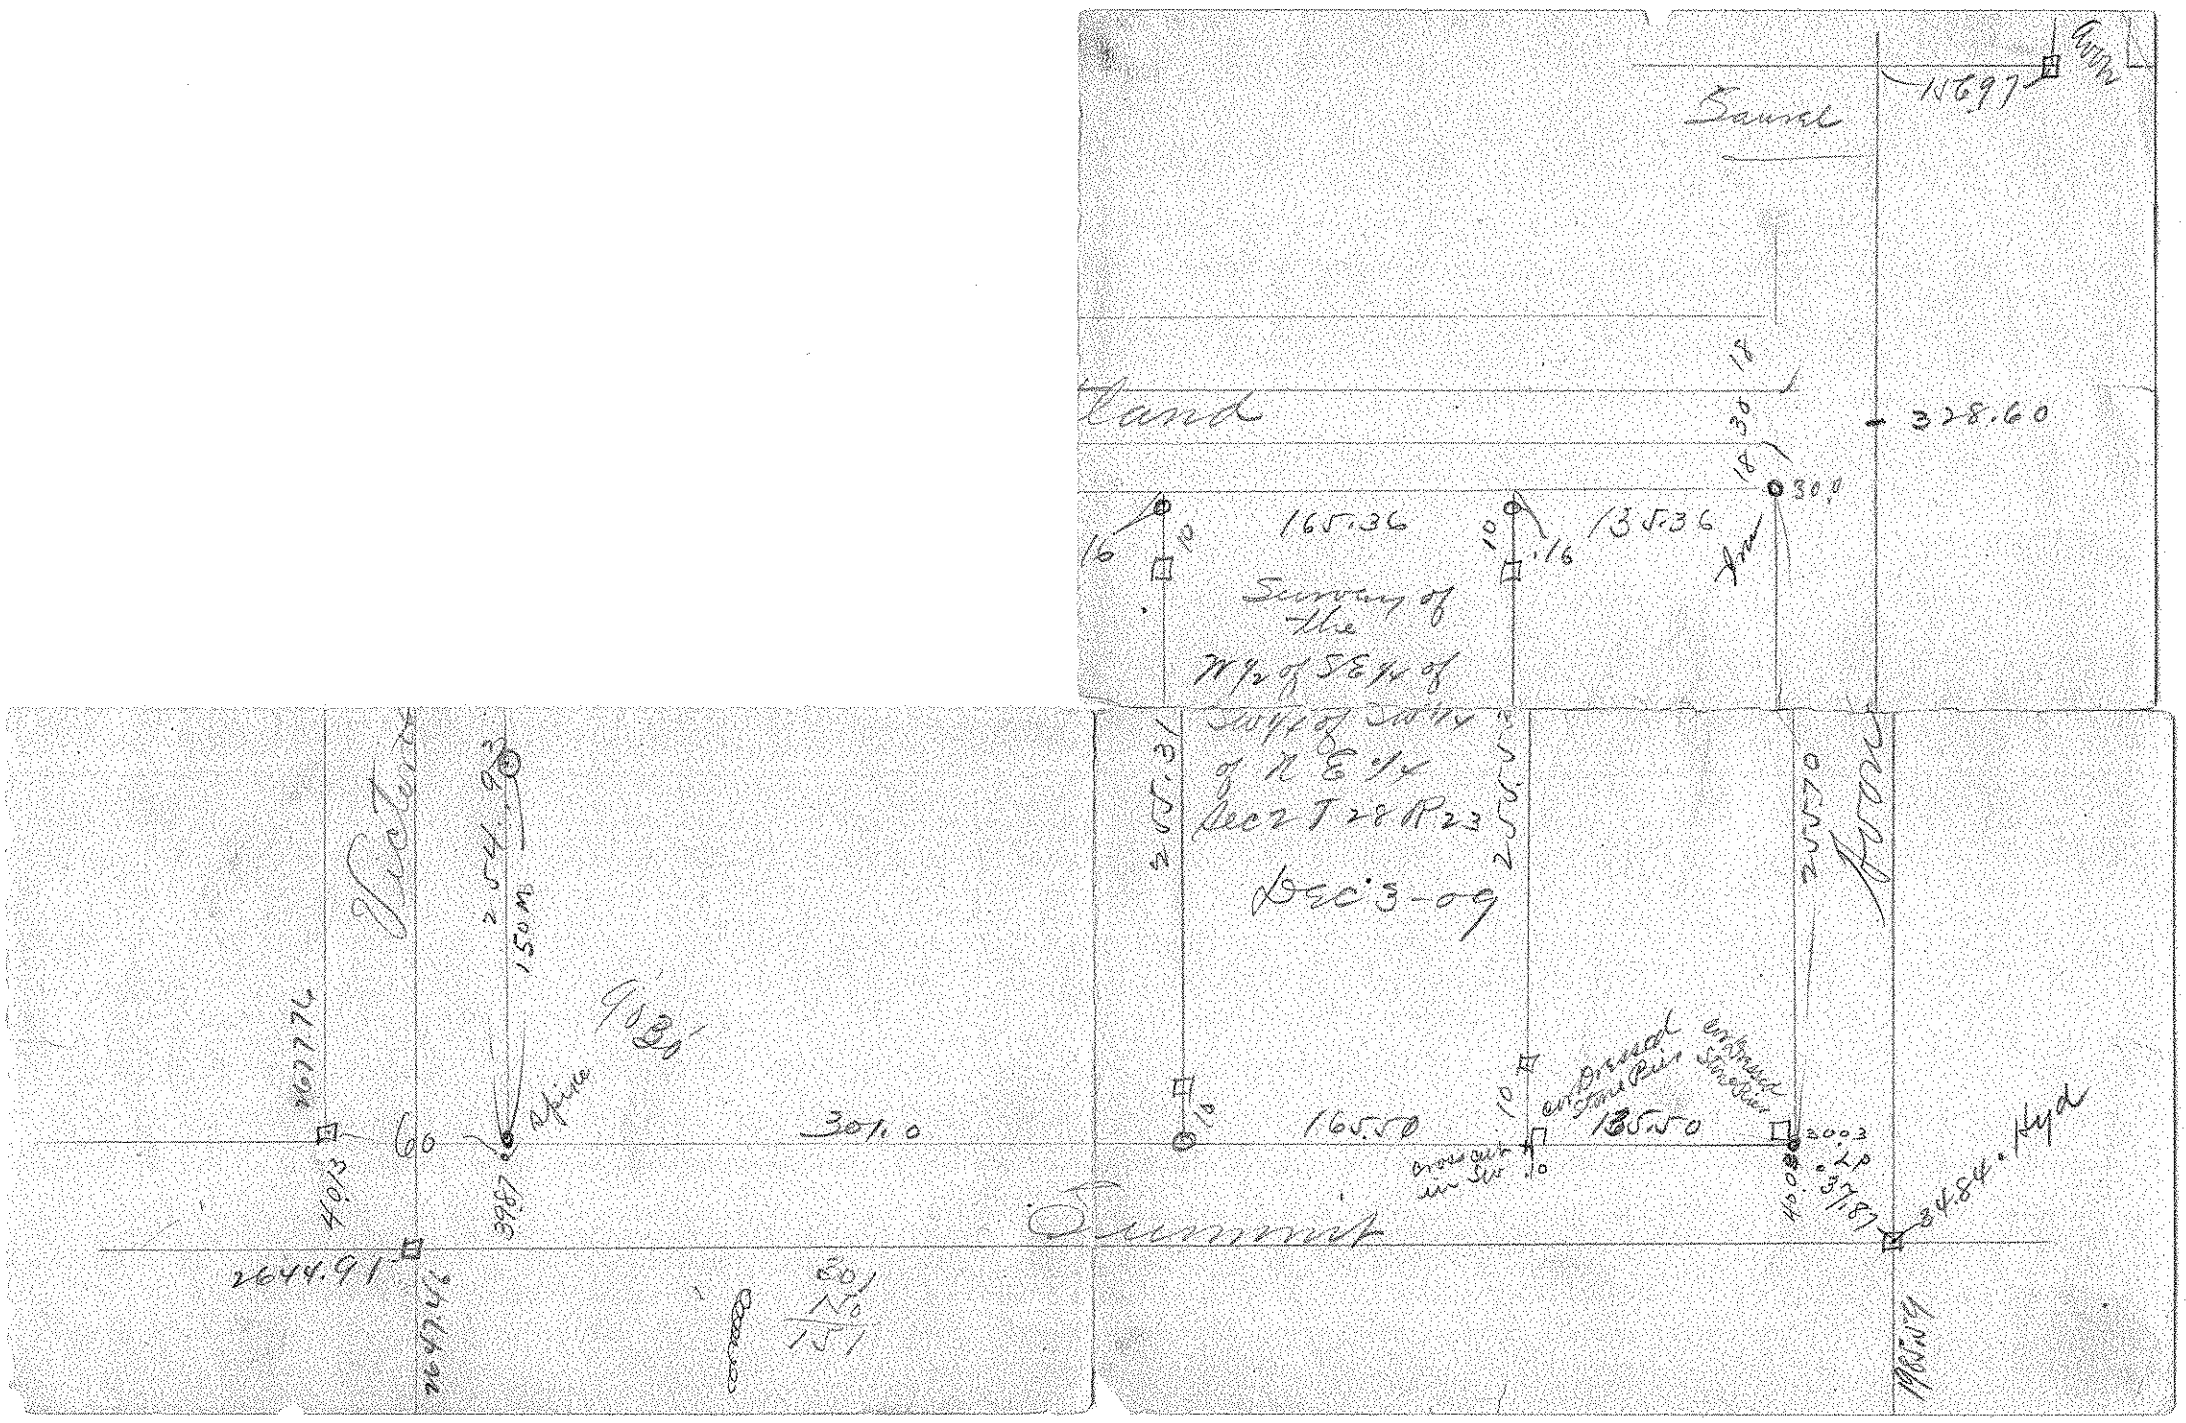
Sand
N697
Sand
328.60
30.0
165.36
Survey of the
N½ of SE¼ of
Dec 3-09
Summit
2644.91
