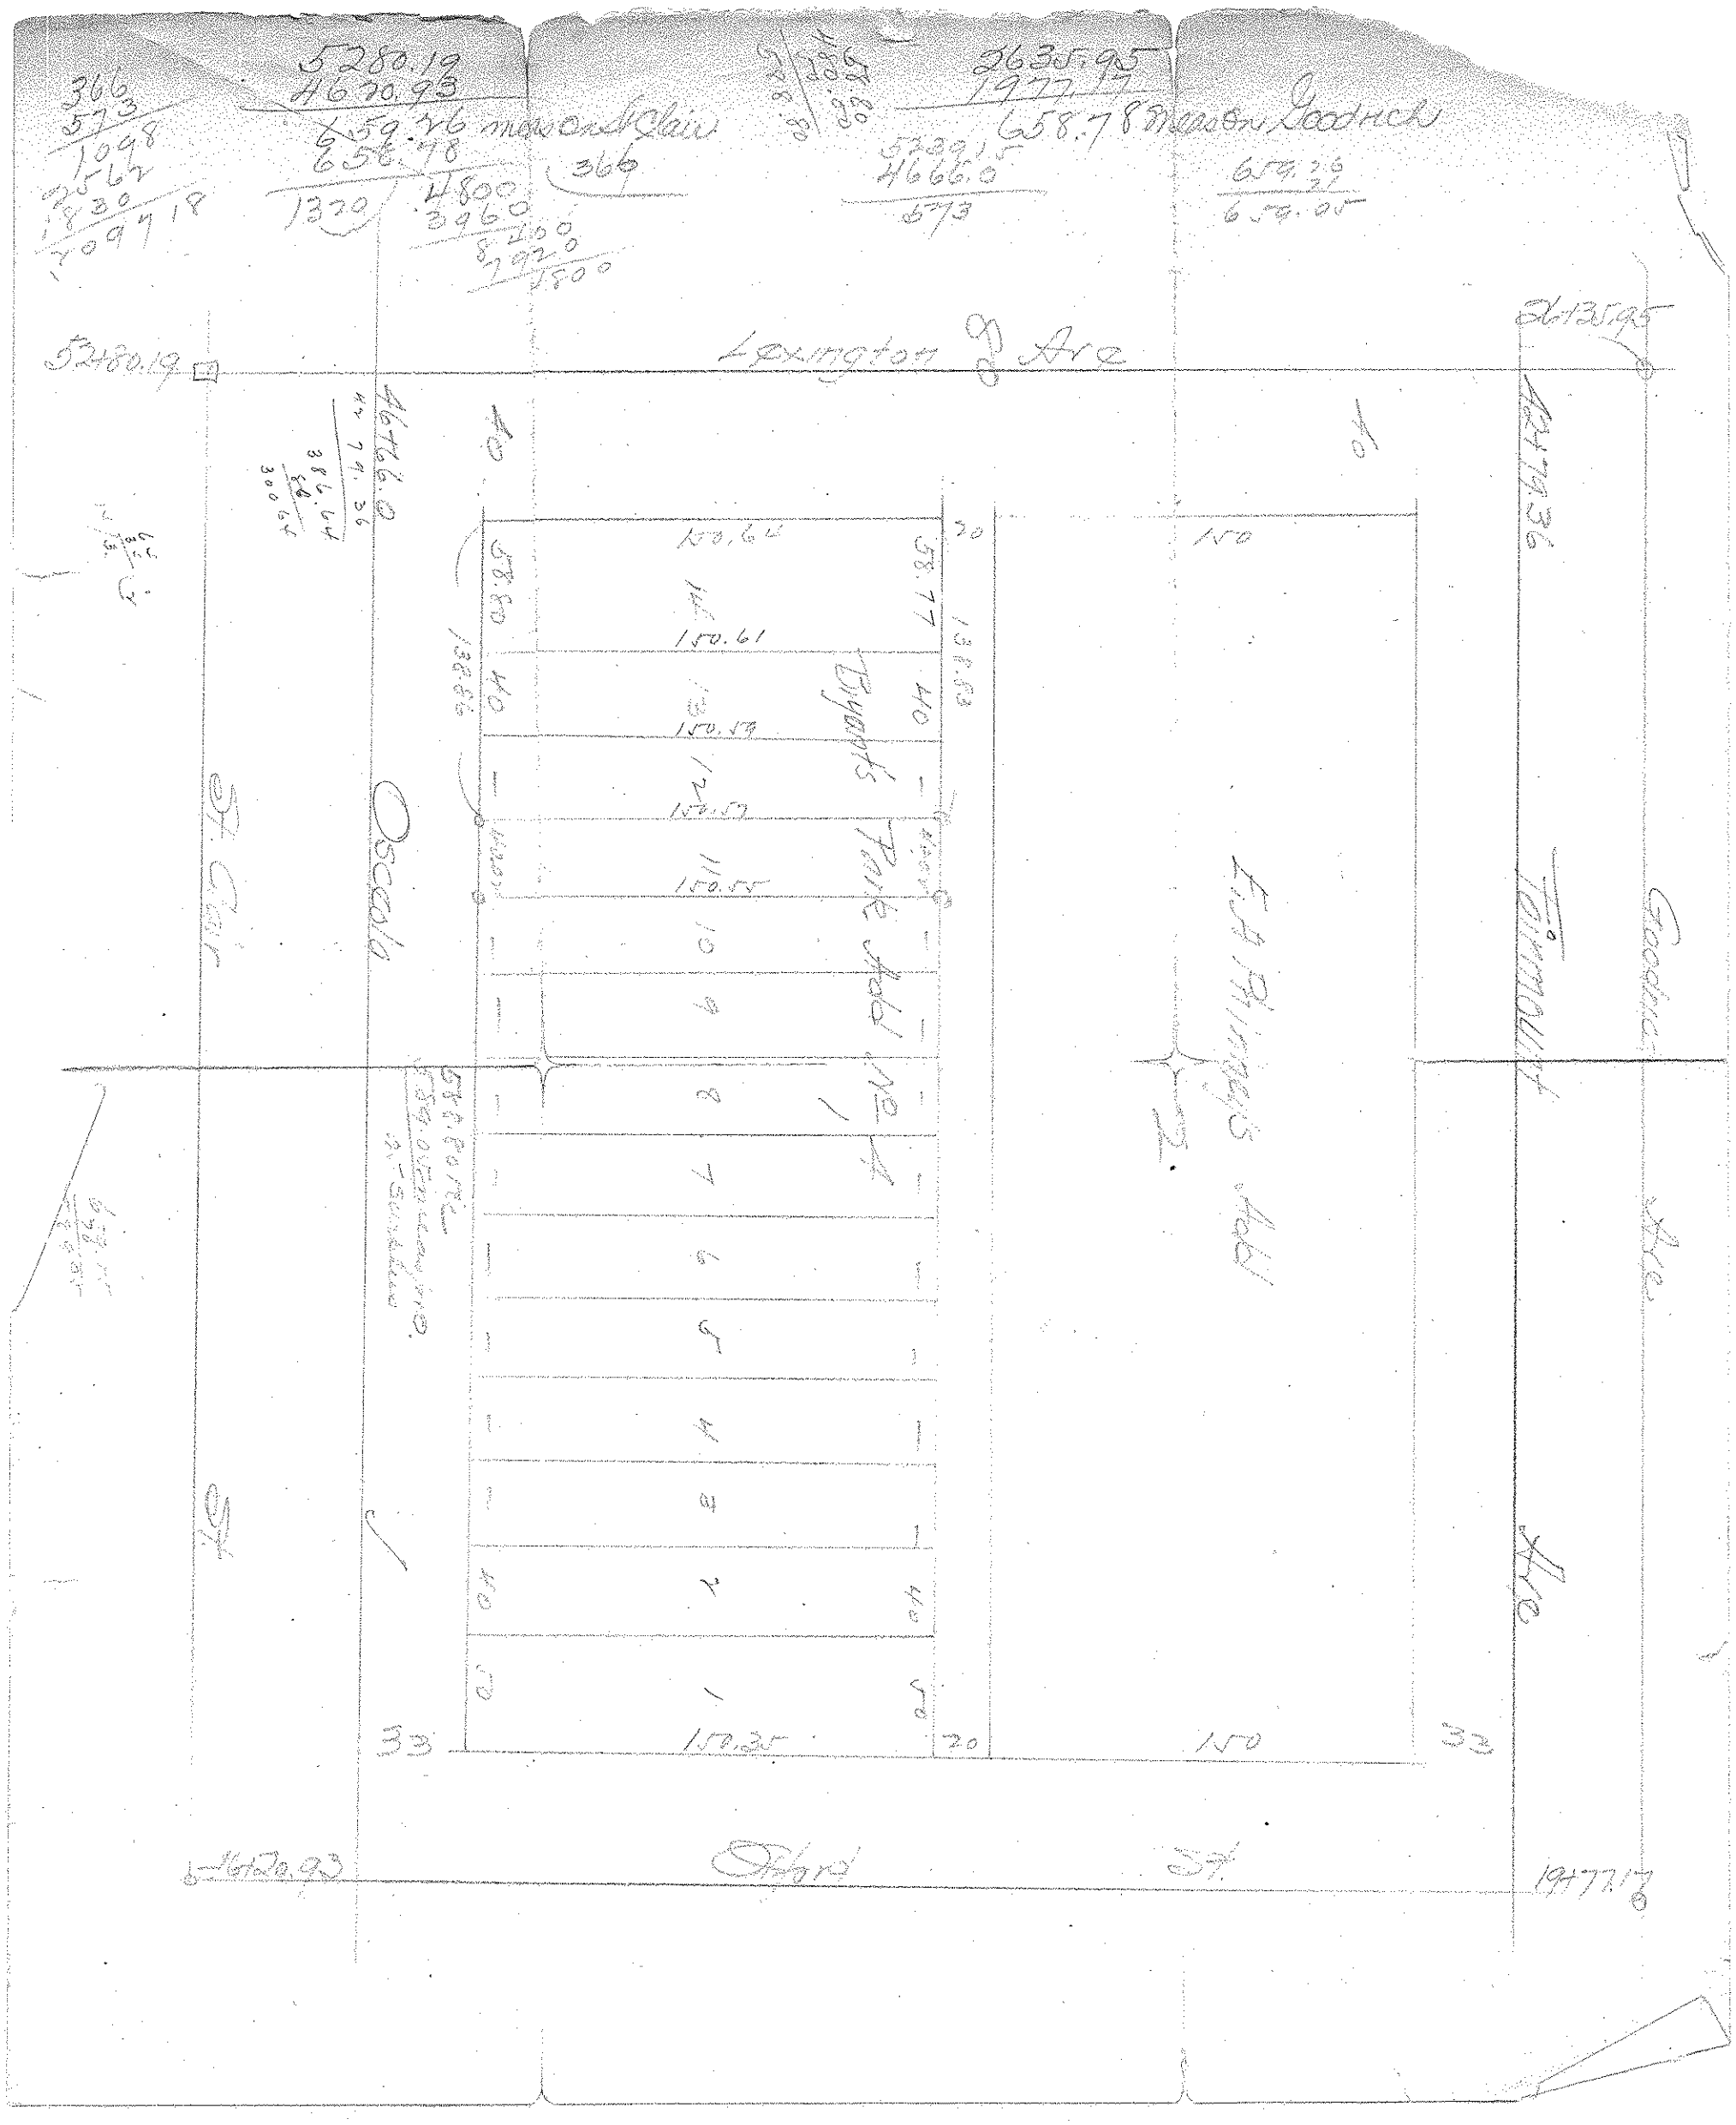
Lexington Ave
Mason
Goodrich
Ave
5280.19
4620.93
659.26
656.78
658.78
1320
4800
3960
1100
5702
1500
2635.95
1977.71
5239.5
4666.0
573
659.26
659.04
1098
2056
1830
2097.18
366
573
369
