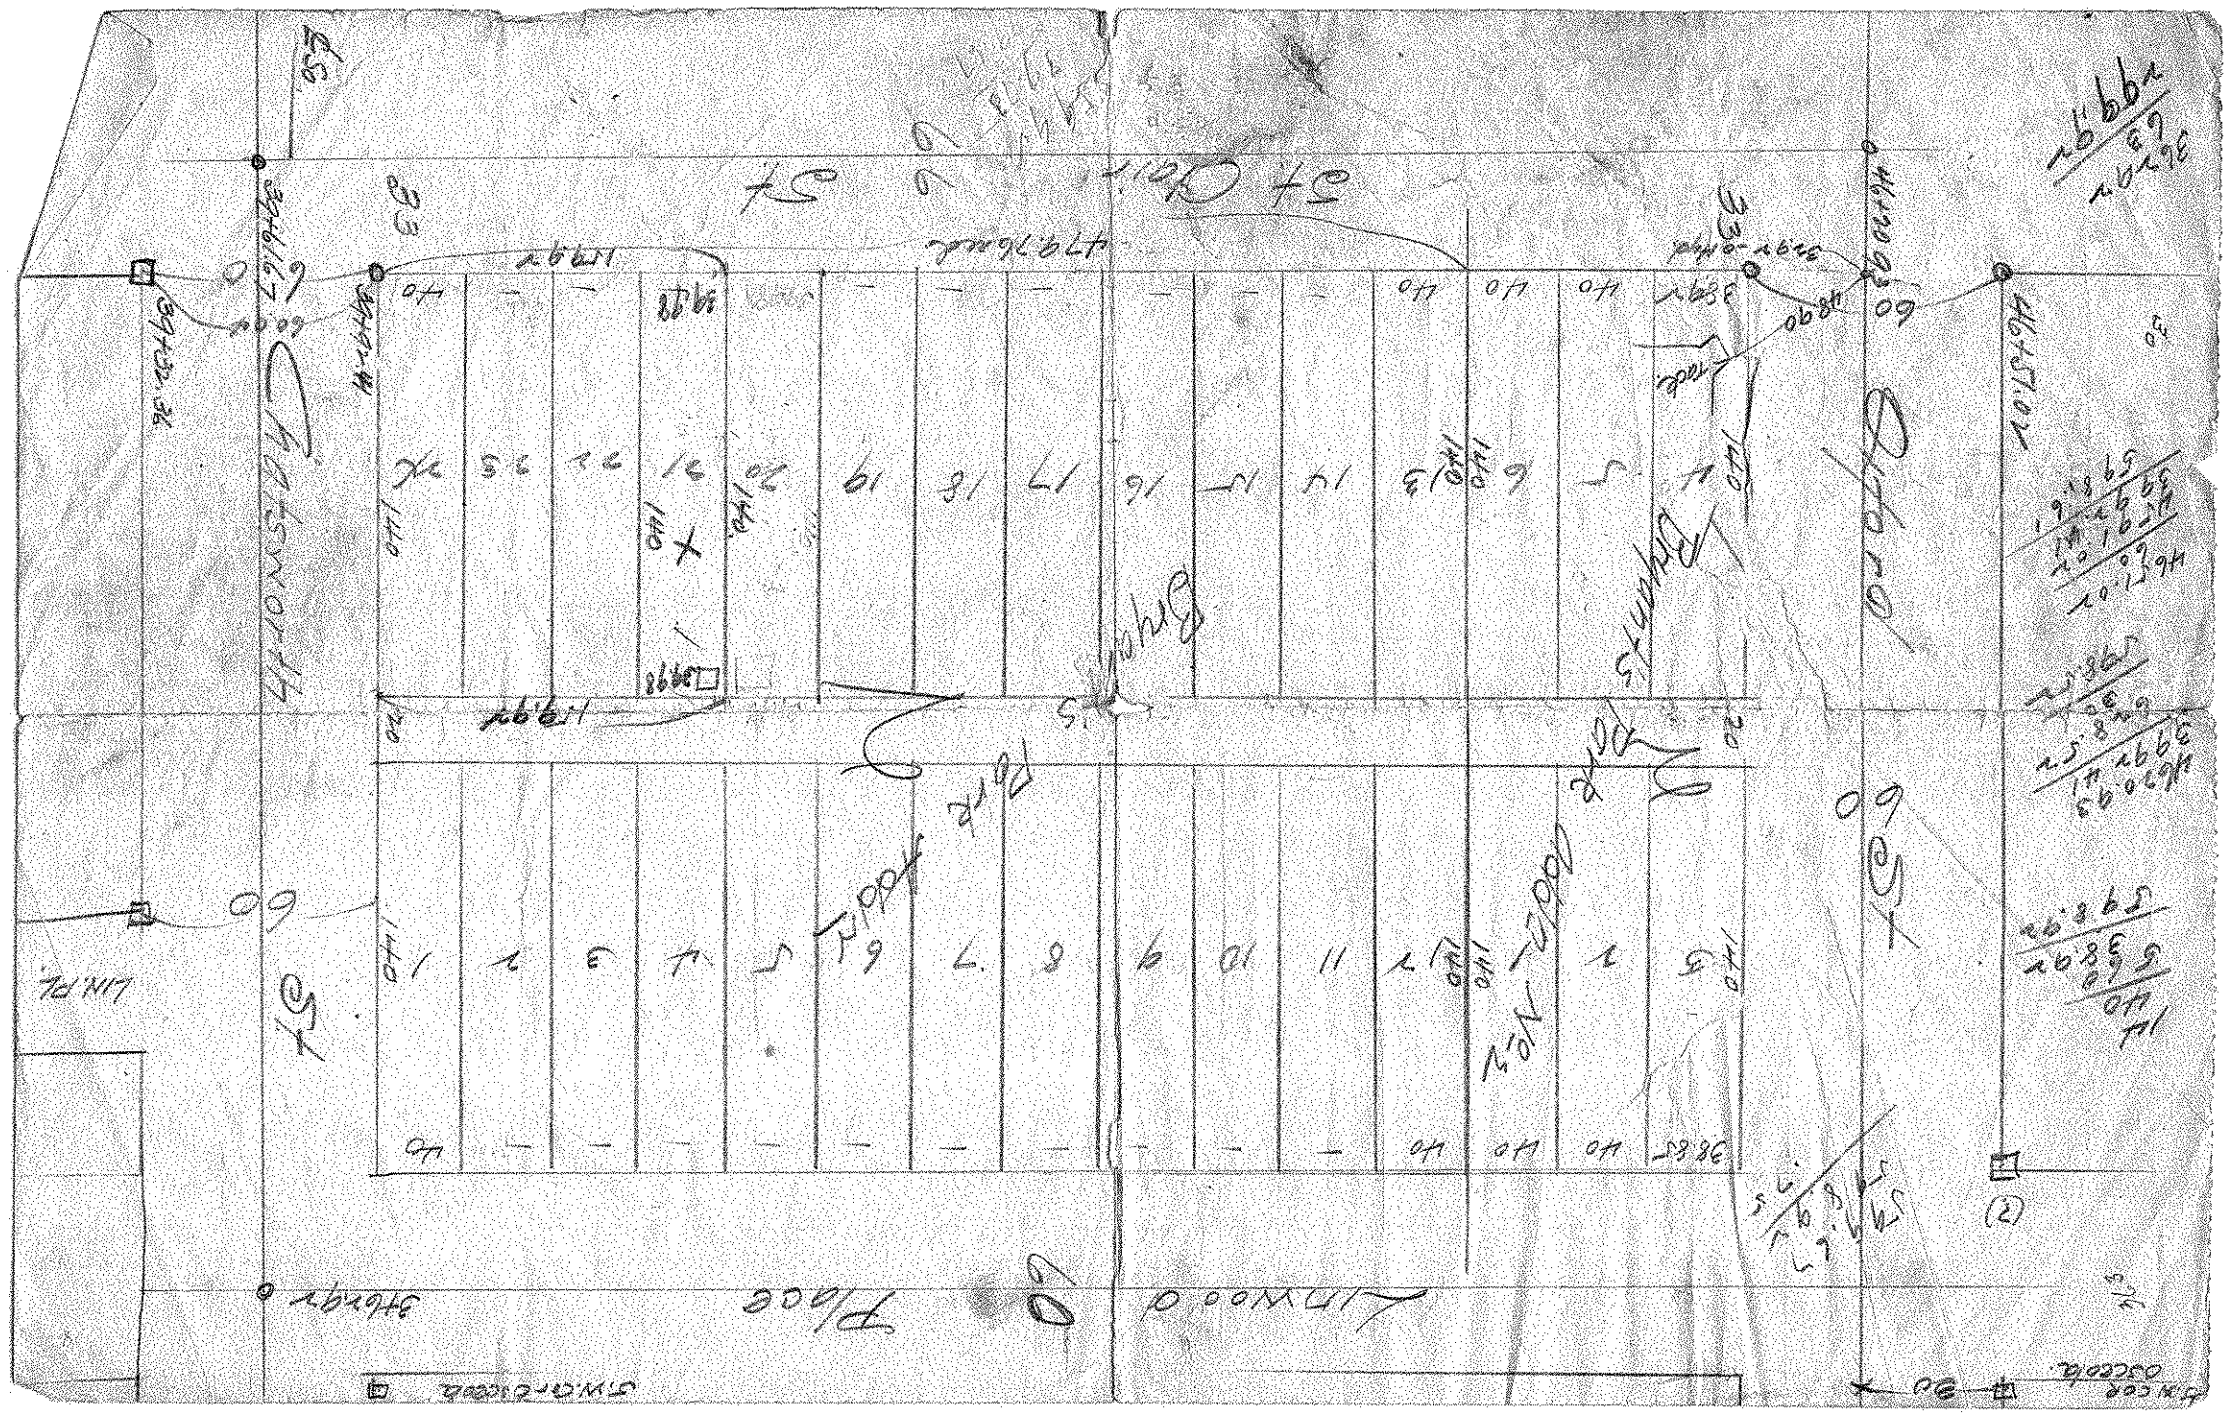

Chatsworth
Oxford
Bryant's Park Addn No. 2
Bryant's Park Addn
Linwood Place
Lin. Pl.
Track