Lot 21 Block 2
Bryant's Park Addn
N.H. Nixon 998 Linwood St.
Q to West Fld. C.
Nov. 28-1919

19/2 Bryants Park addn
#1003 N Blair St.
Queen Stringer

19/2 Bryants Park add
998 Linwood St
Queen Stringer
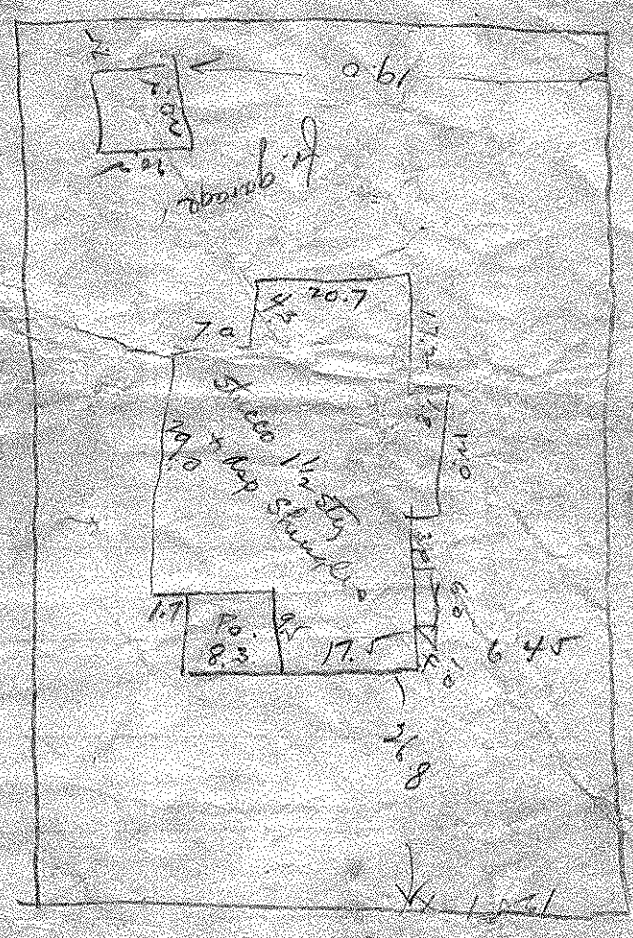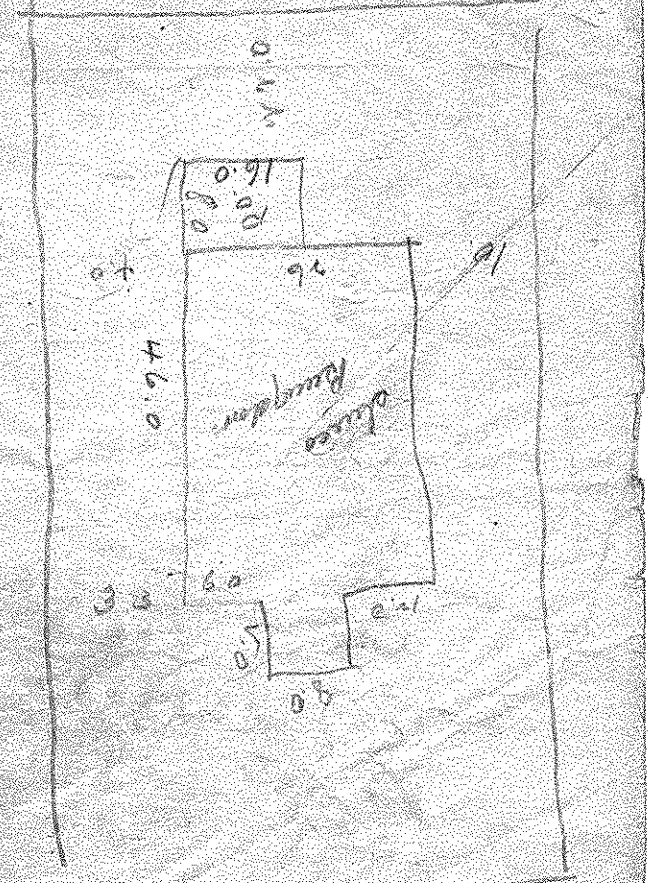
20/2 Bryants Park add
998 N Blair St.