


NORTH 119.16 ft.
EXCEPT NORTH 10 ft. for
SELBY AVE. WIDENING
LOT 3 BLOCK 18
BOULEVARD ADD,

NO 2,
JOHN B. IRVINE, SURVEYOR.
ST. PAUL, MINN.
MAY 4-1916
Scale 20 ft. per inch.

SELBY FIVE,

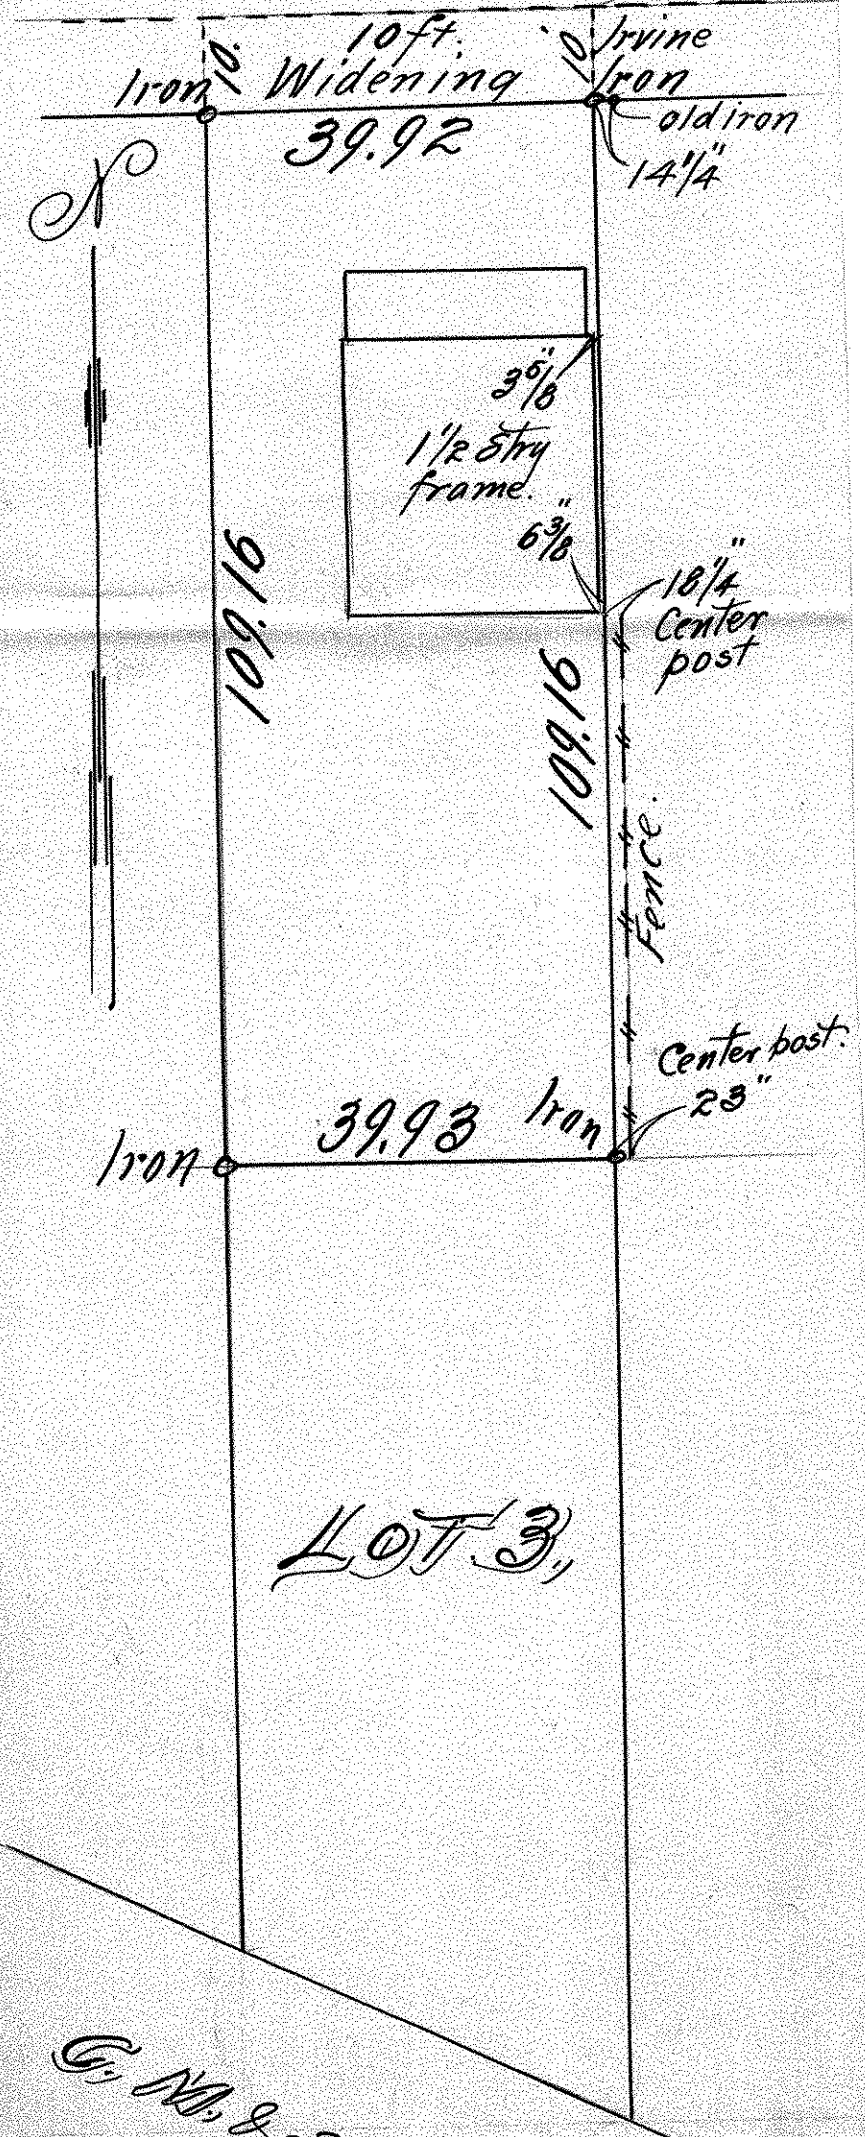

C. N. & St. P. R.R.