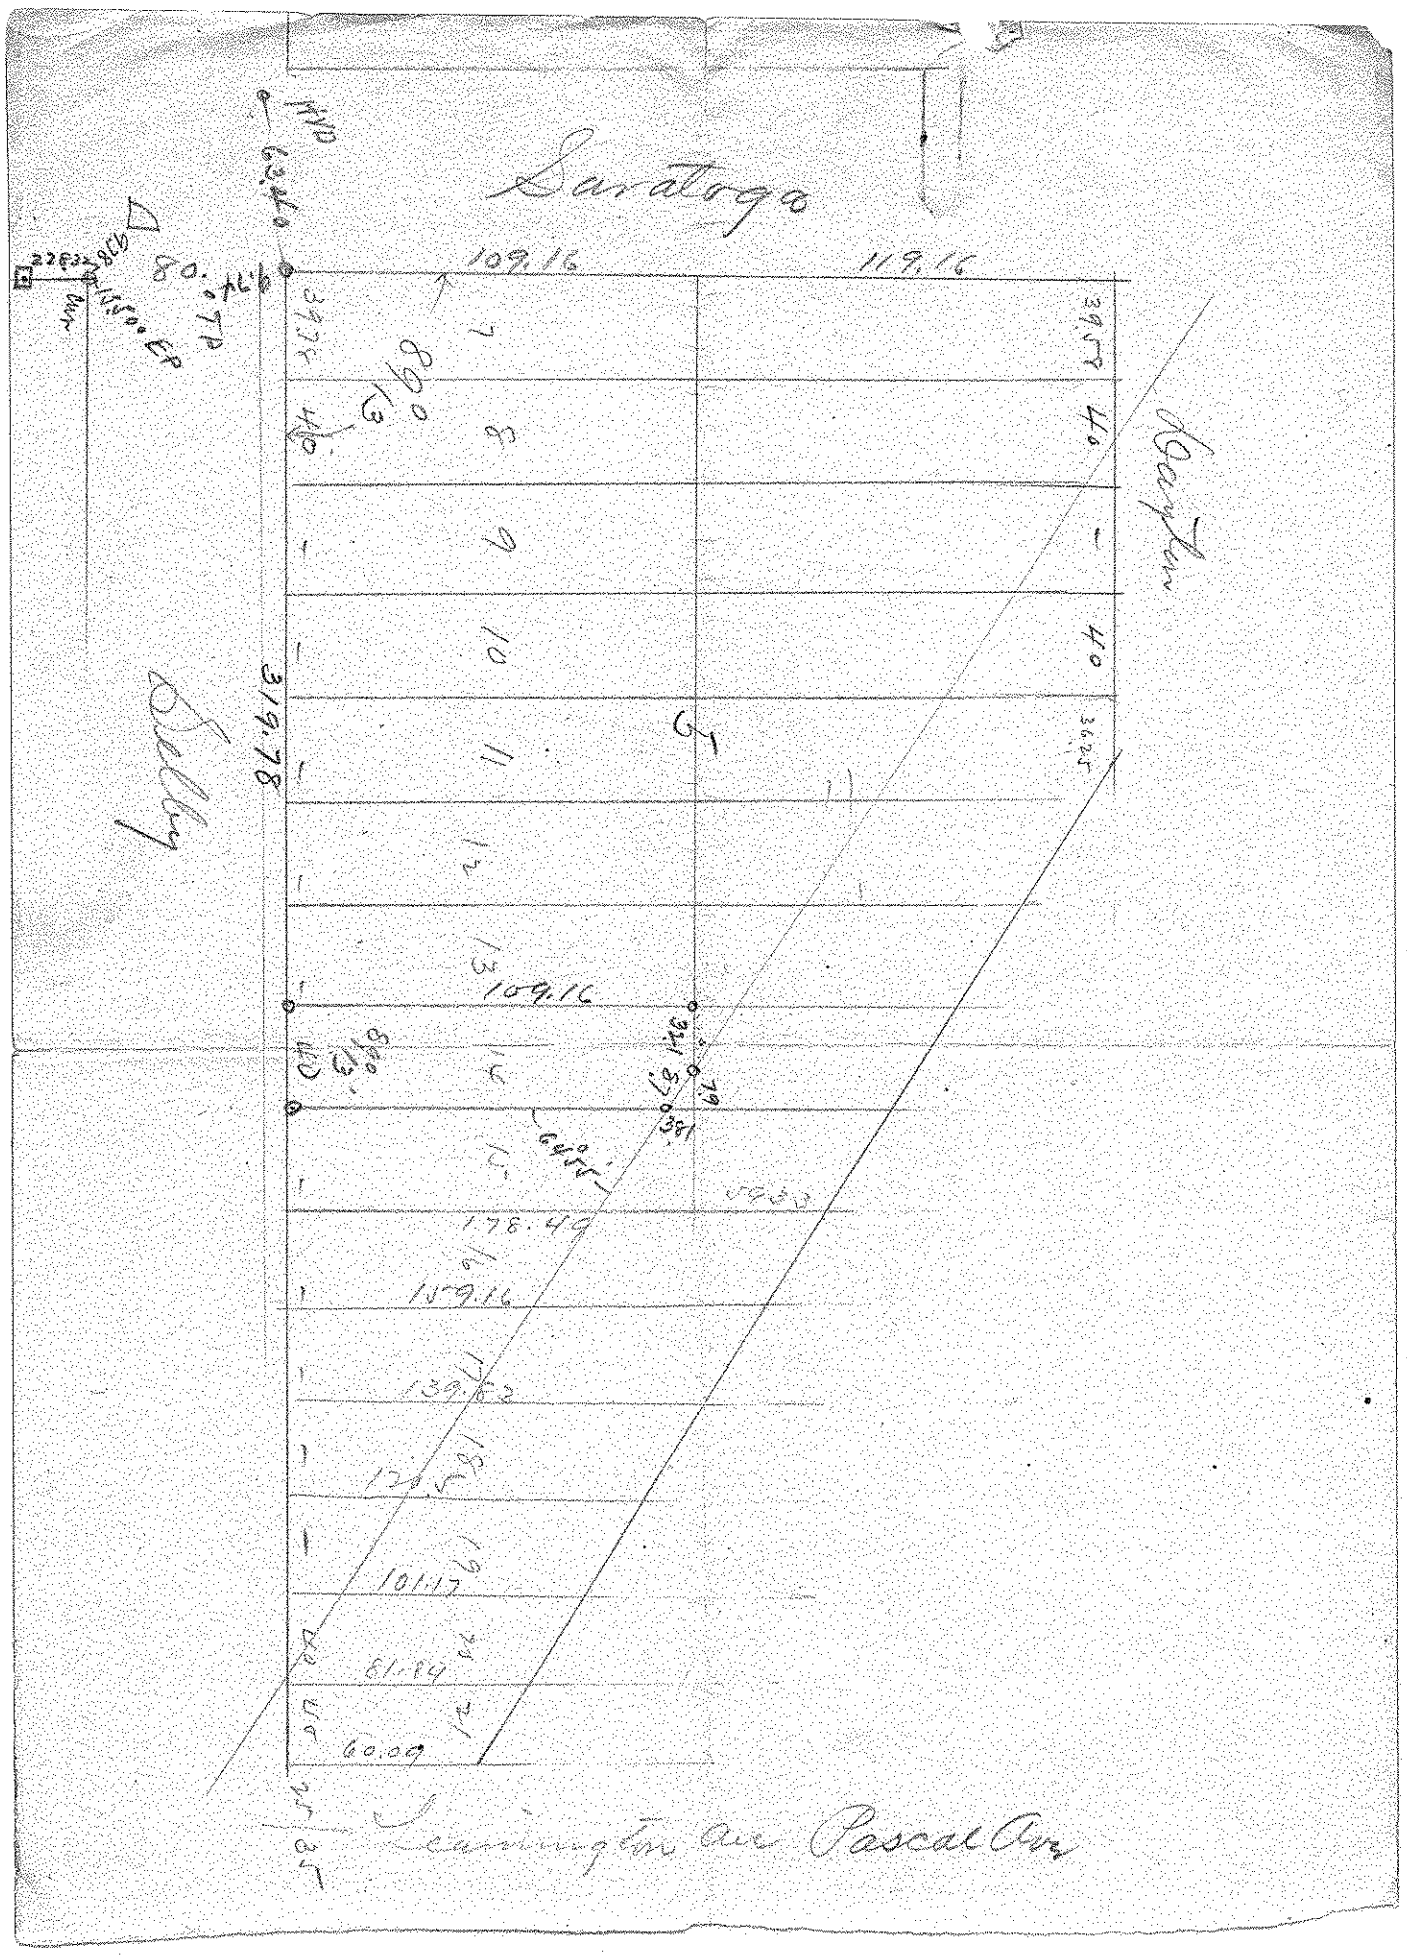
Saratoga
109.16
119.16
Lexington Ave
Pascal Ave
Selby
109.16
178.49
139.62
120.81
101.12
61.84
60.00