


Smelling Ave

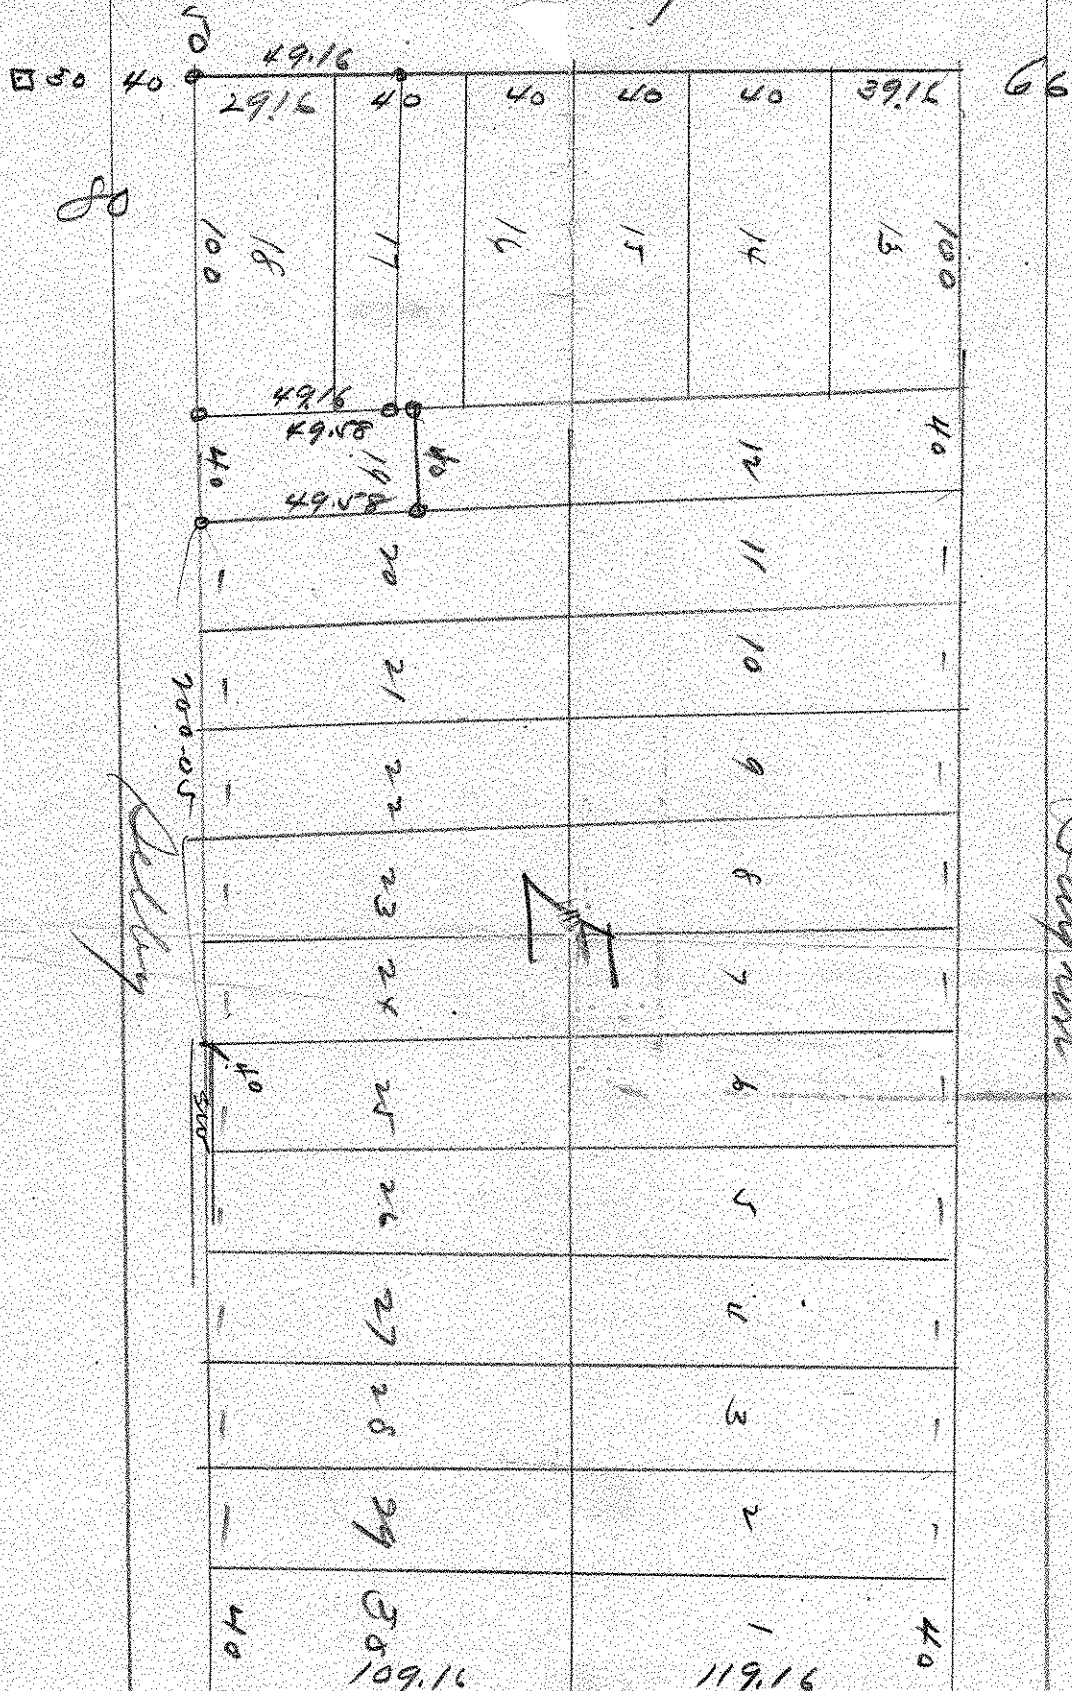

Daratoga