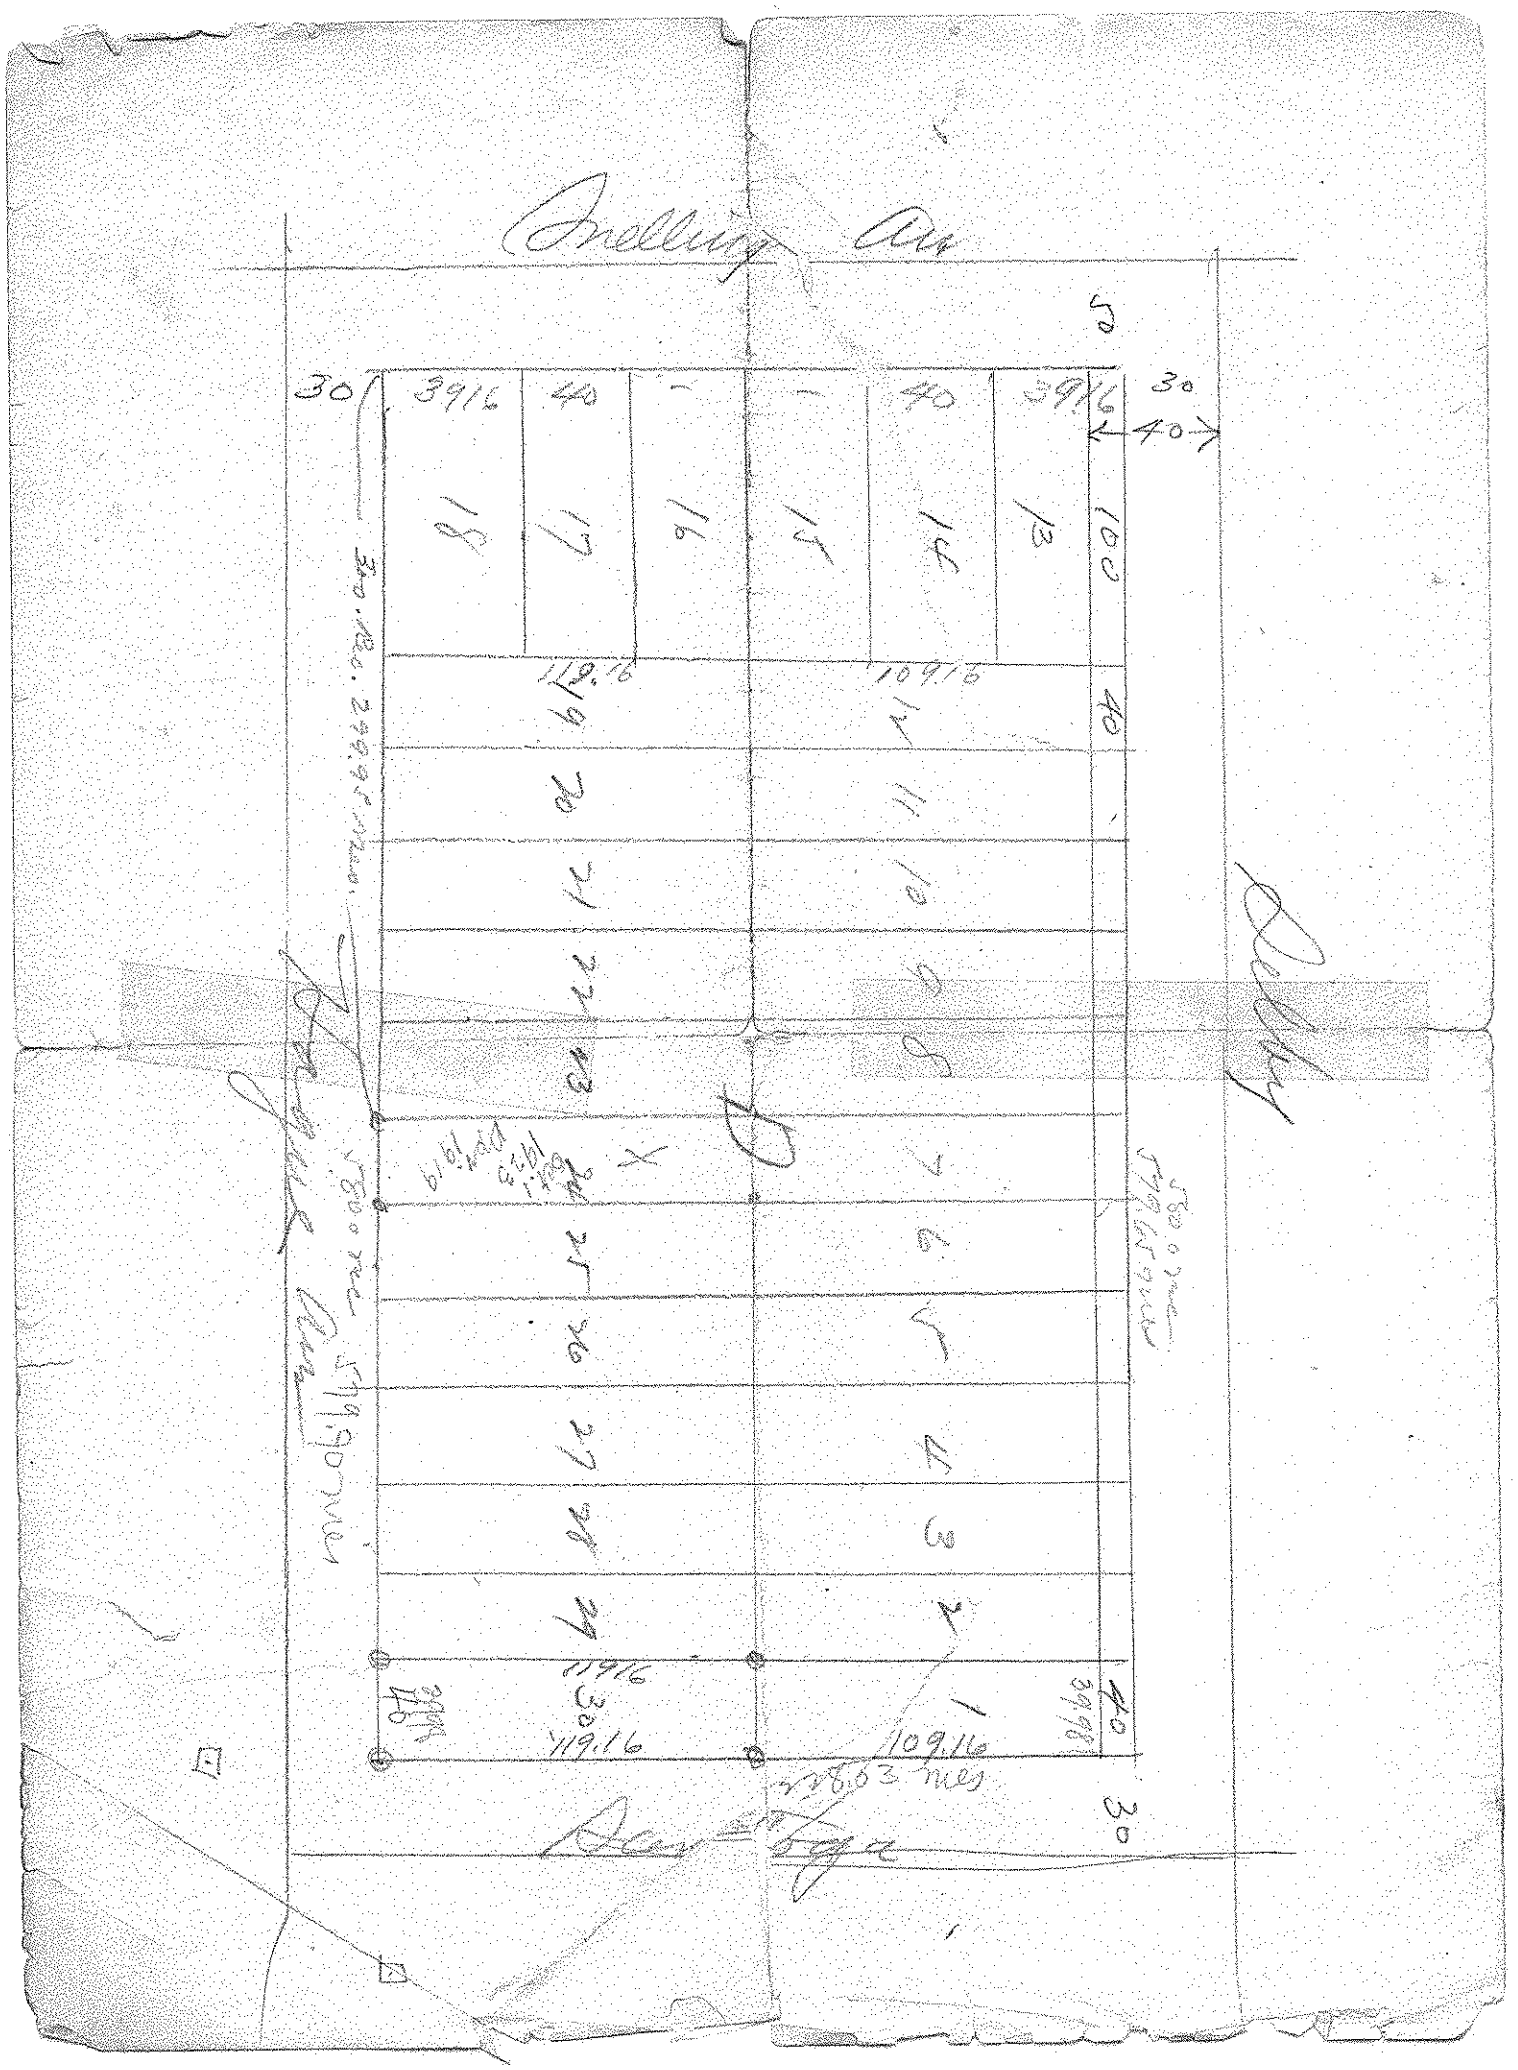
Snelling Ave
Delhi
Saratoga
30
39.16
40
18
17
16
15
14
13
100
119.16
109.16
19
20
21
22
23
24
25
26
27
28
29
12
11
10
9
8
7
6
5
4
3
2
1
30.130.299.95 mes
579.90 mes
228.03 mes