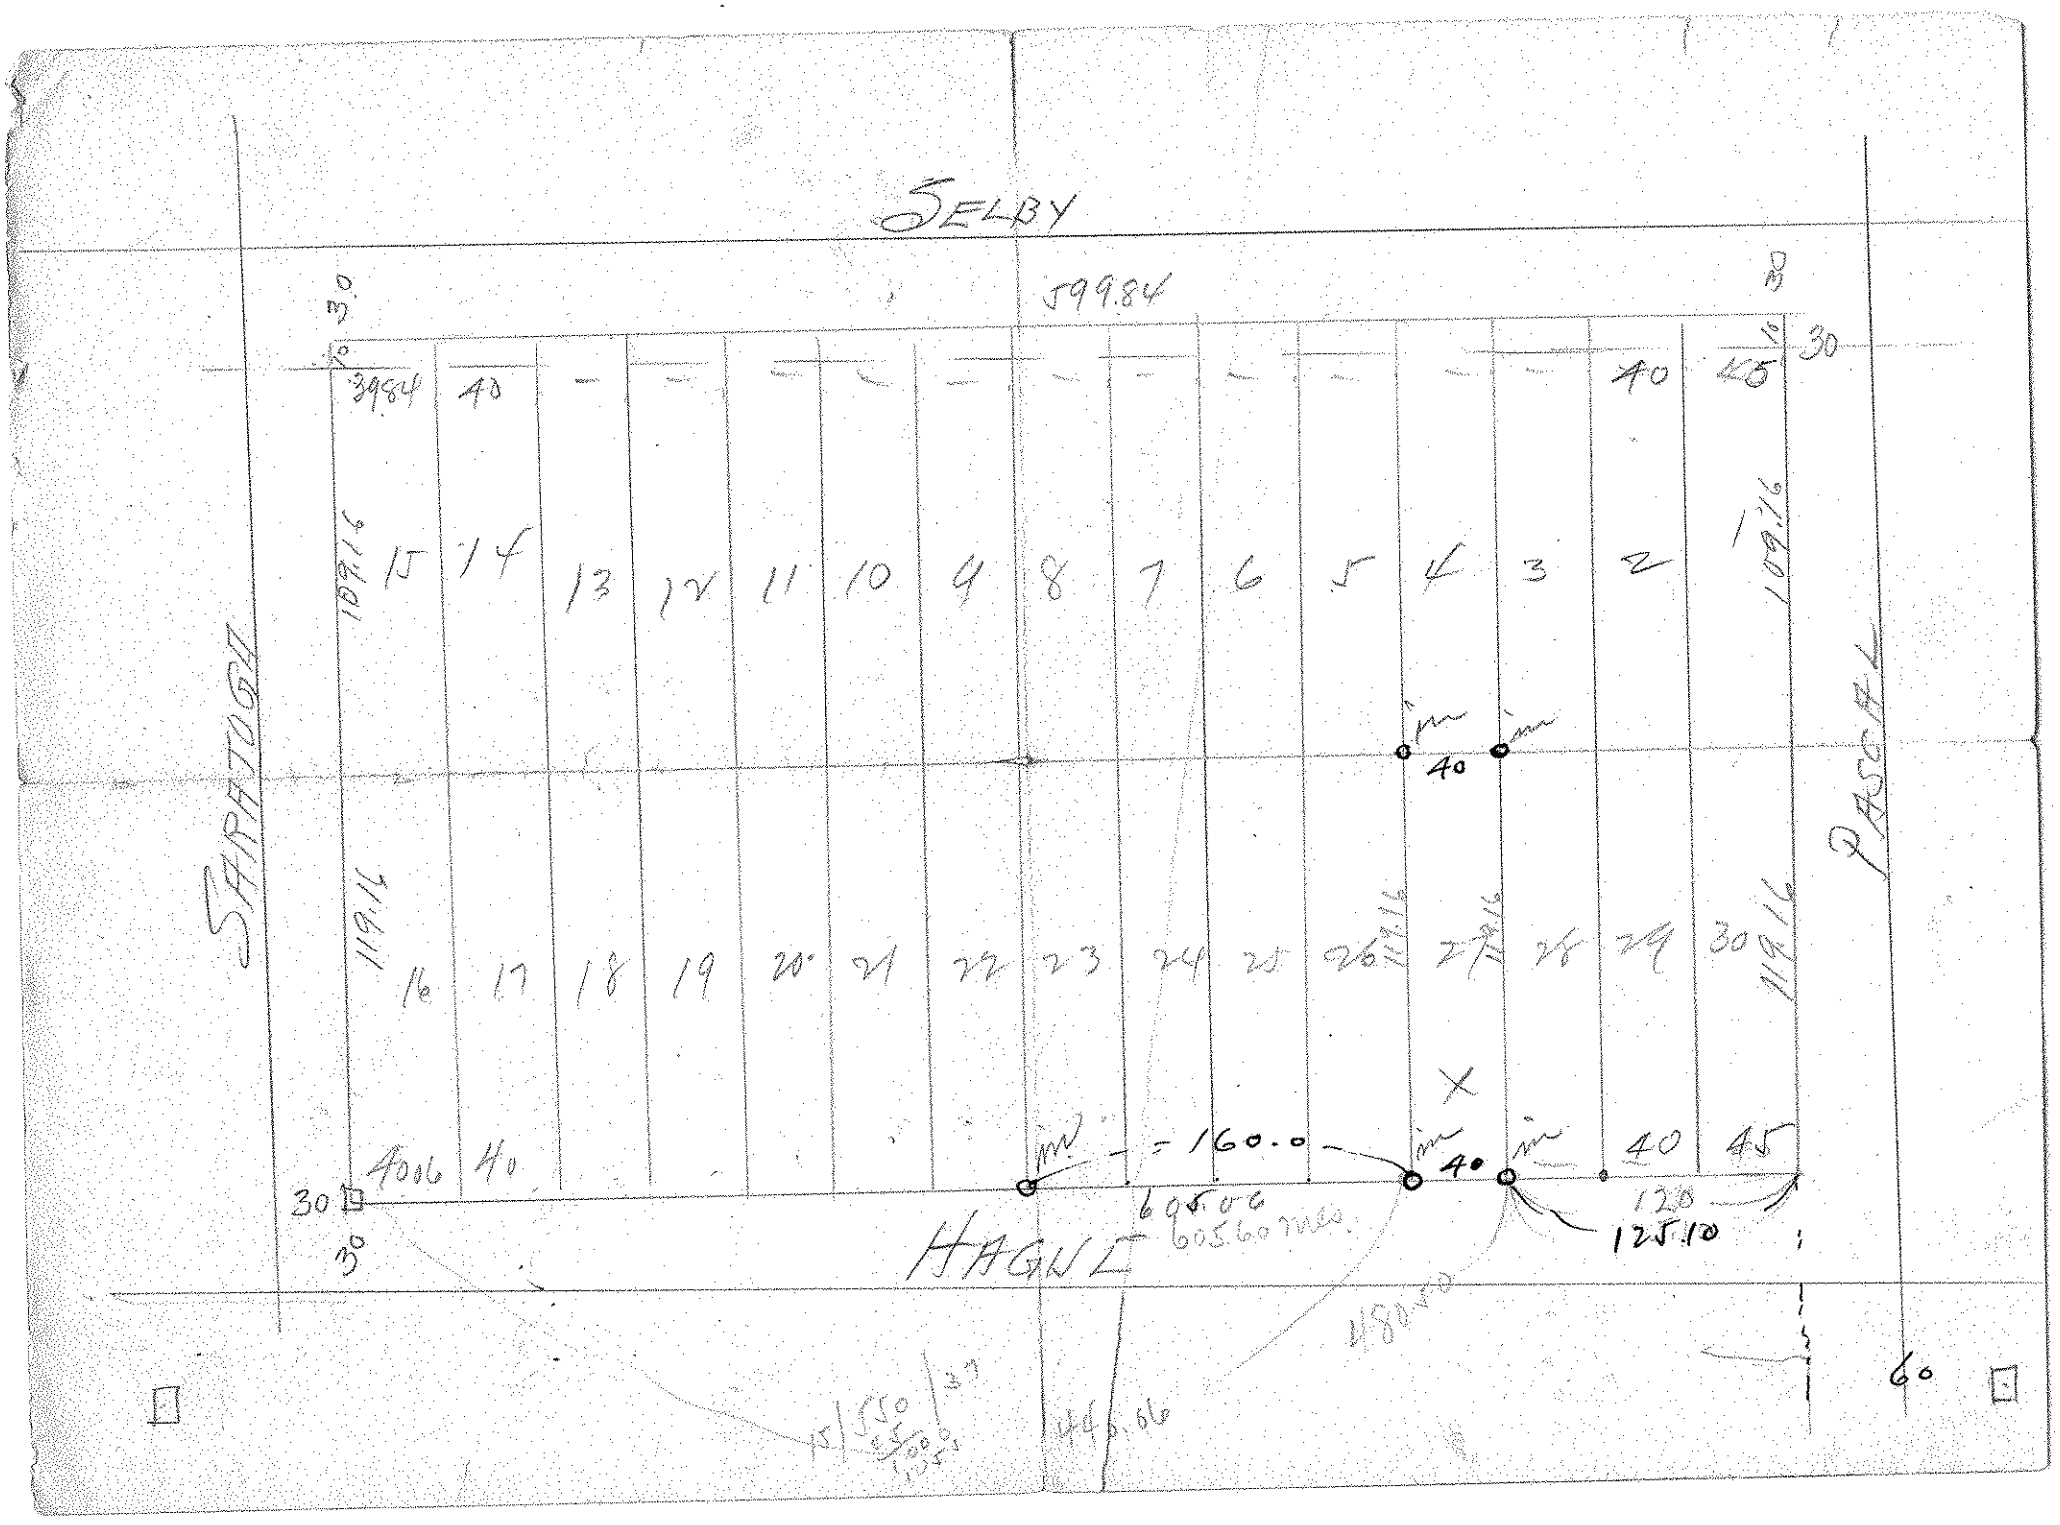
SELBY
SARATOGA
PASCHAL
HAGUE
3984
40
30
40
45
160.0
120
125.10
60