

579376
182672
39654

157.75
156.26
33
347.01

X No side

22' E of E rail

4' no of paving

X No side


28' N of E rail

6' do of paving


Lots 8-9-10 B 70
Boulevard Add #2



11 = 001
12 = 002
13 = 003

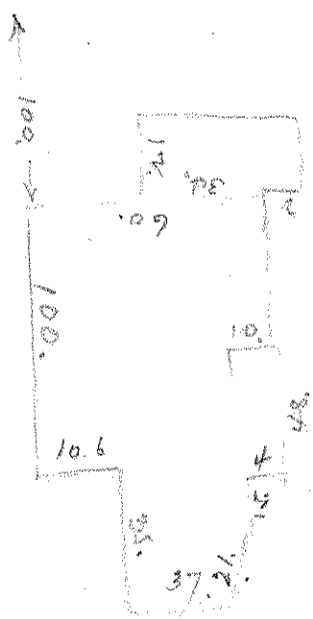

building

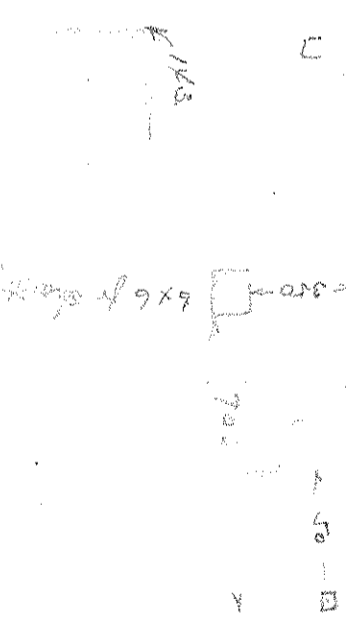

11 = 001
12 = 002
13 = 003