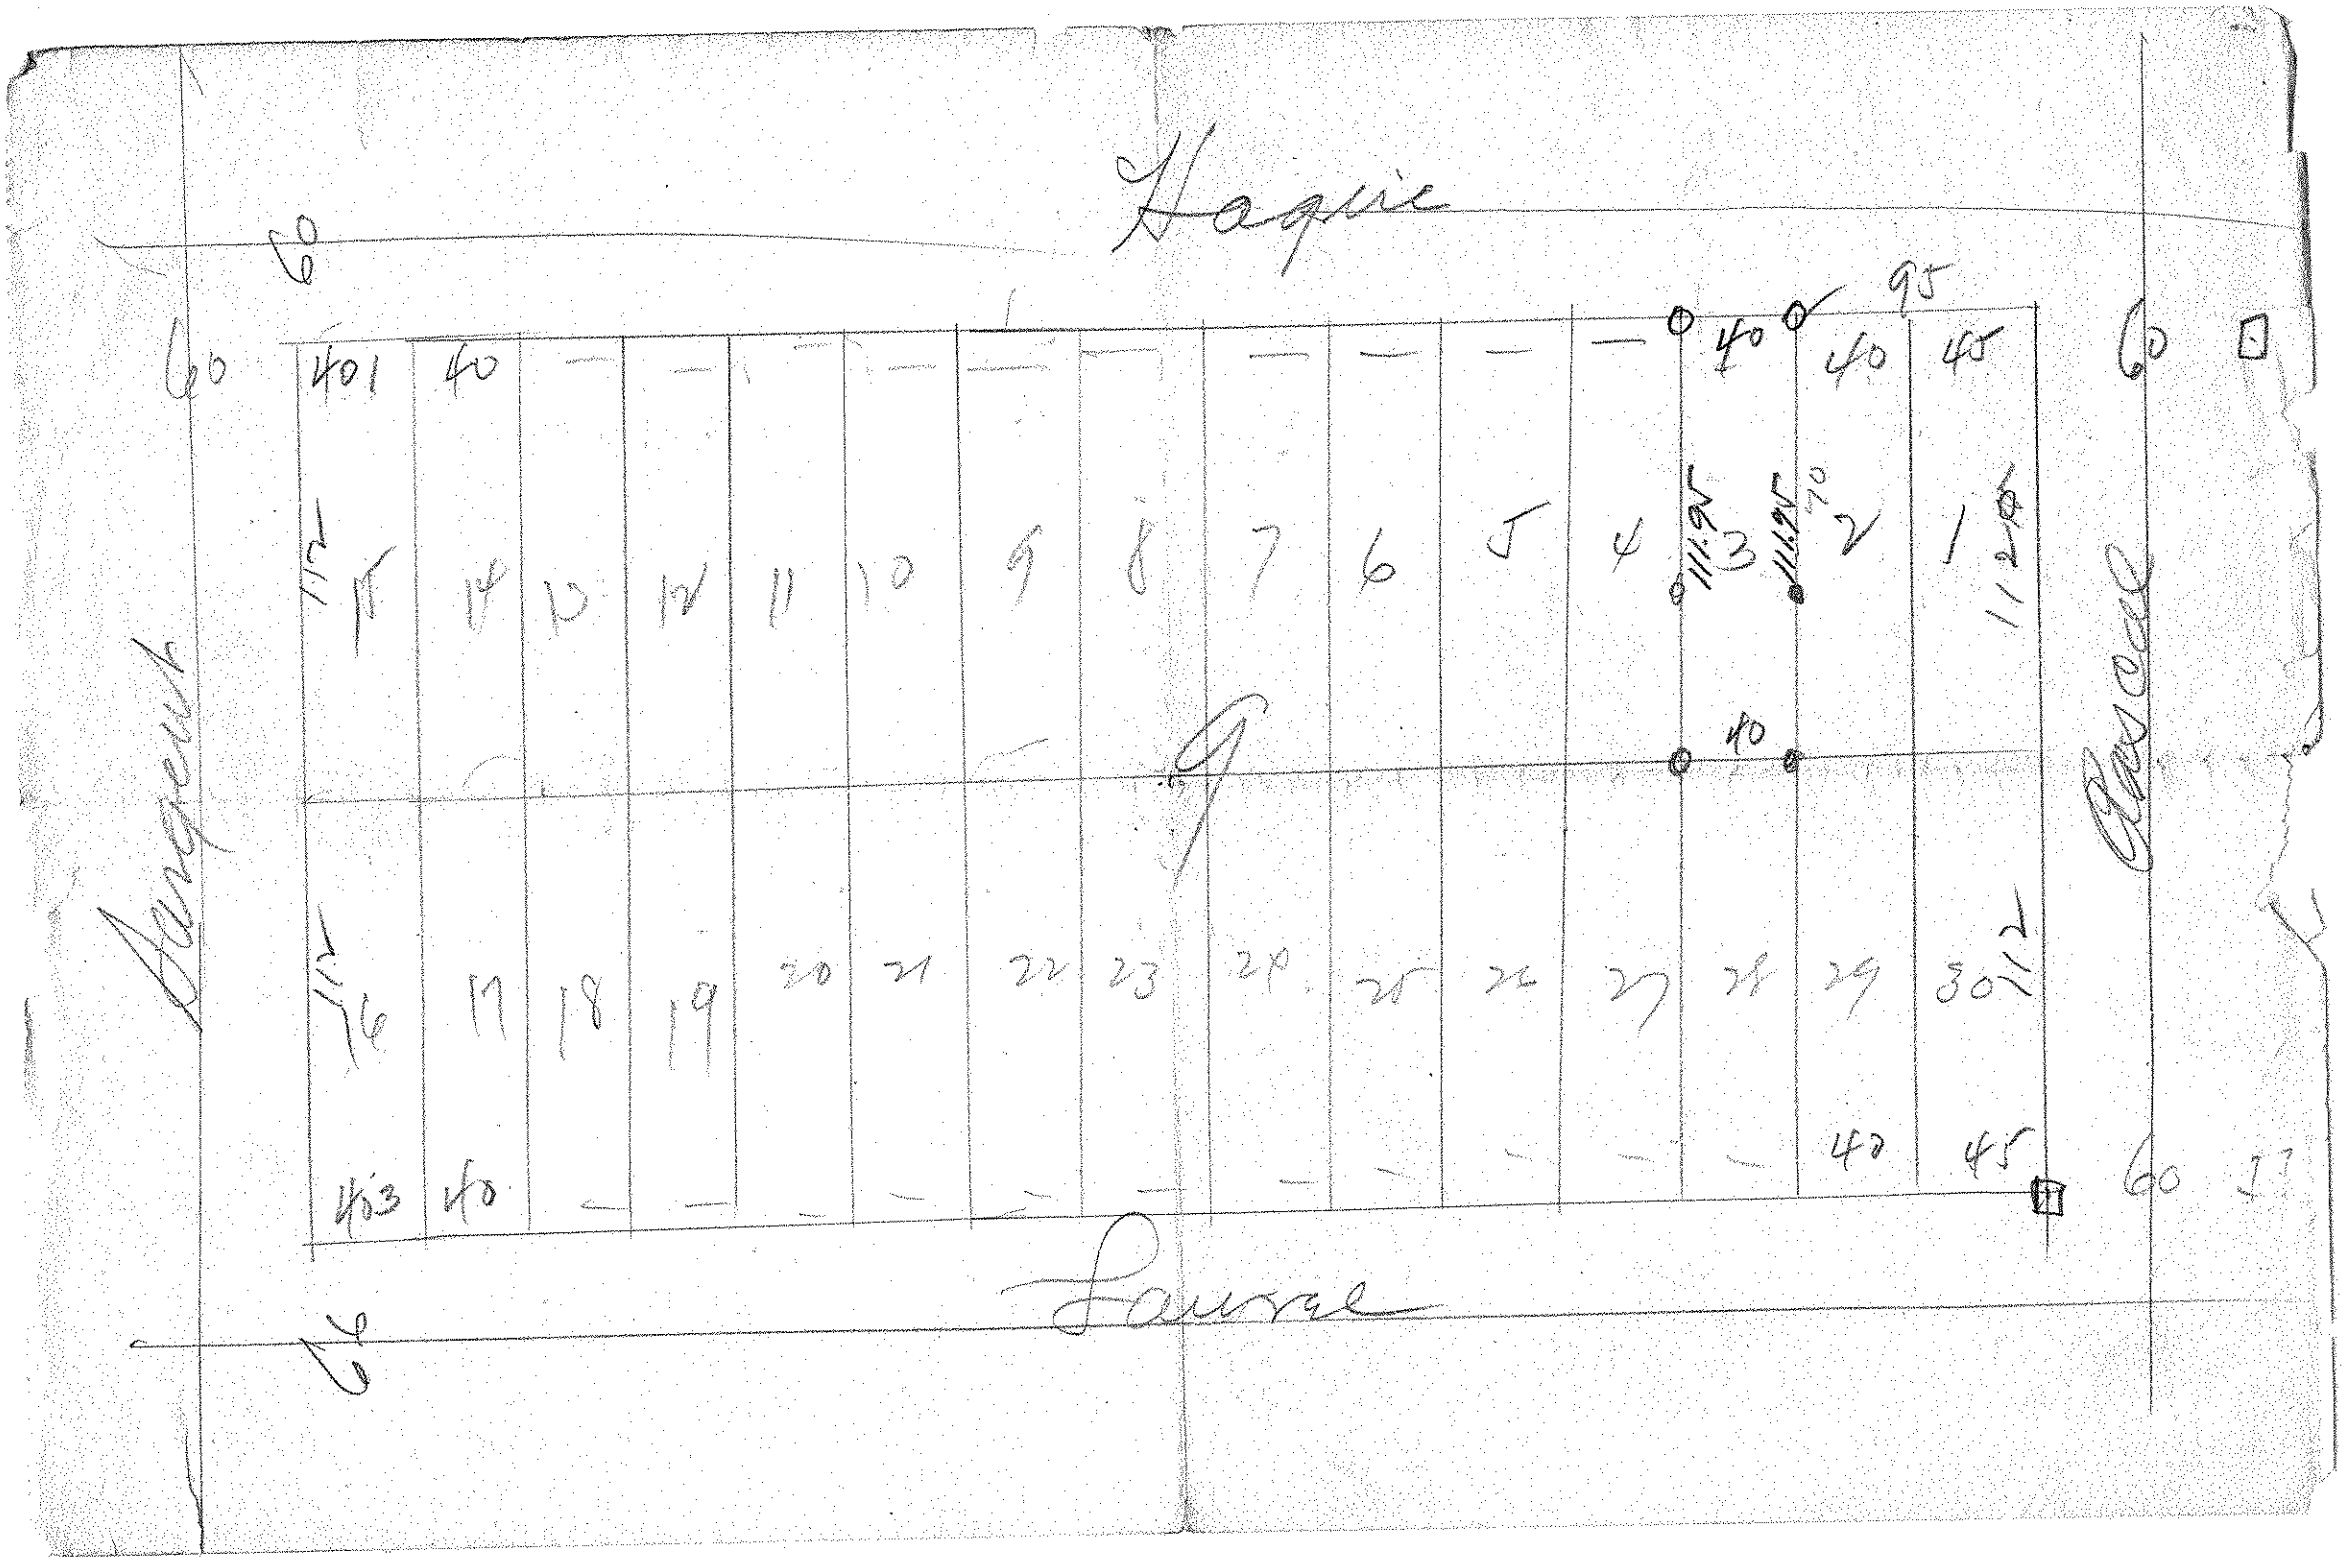
Haque
Sargent
Lavrac
Pascal
60
95
40
45
111.95
112