LOT 13, BLOCK 5,
BOULEVARD ADD.
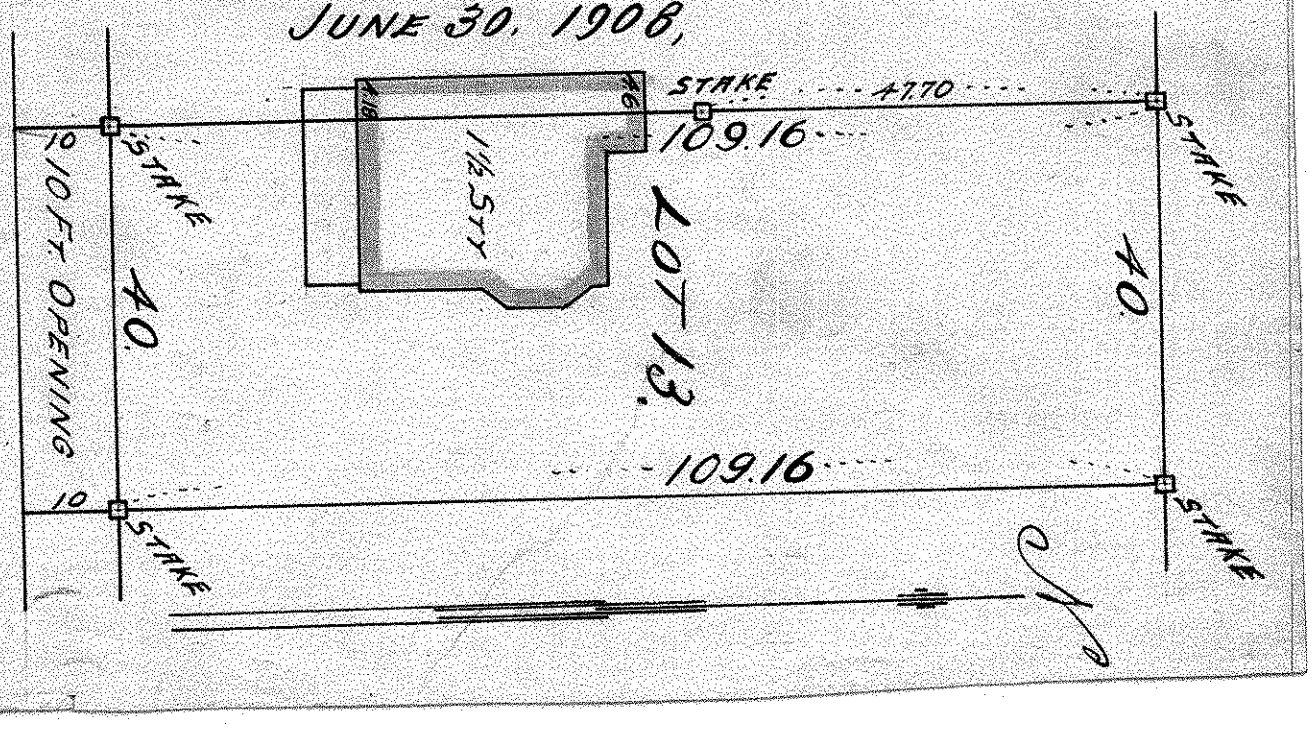
JOHN B. IRVINE, SURVEYOR.
ST PAUL, MINN.
SCALE 20 ft. per inch.
JUNE 30, 1908.