

COMSTOCK AND DAVIS INC.


3092 N. LEXINGTON AVE. ST. PAUL, MN. 55113 483-4408

SURVEYED FOR: Aaron Frieberg

DESCRIPTION: Lot 10, Block 4, Bisanz Brothers Addition No. 2, Ramsey County, Minn.

Irons found as per survey by John R. Turpin survey of July 21, 1976
Located also on Georgi-Schmidt survey dated July 31, 1981

SAINT PAUL AVENUE

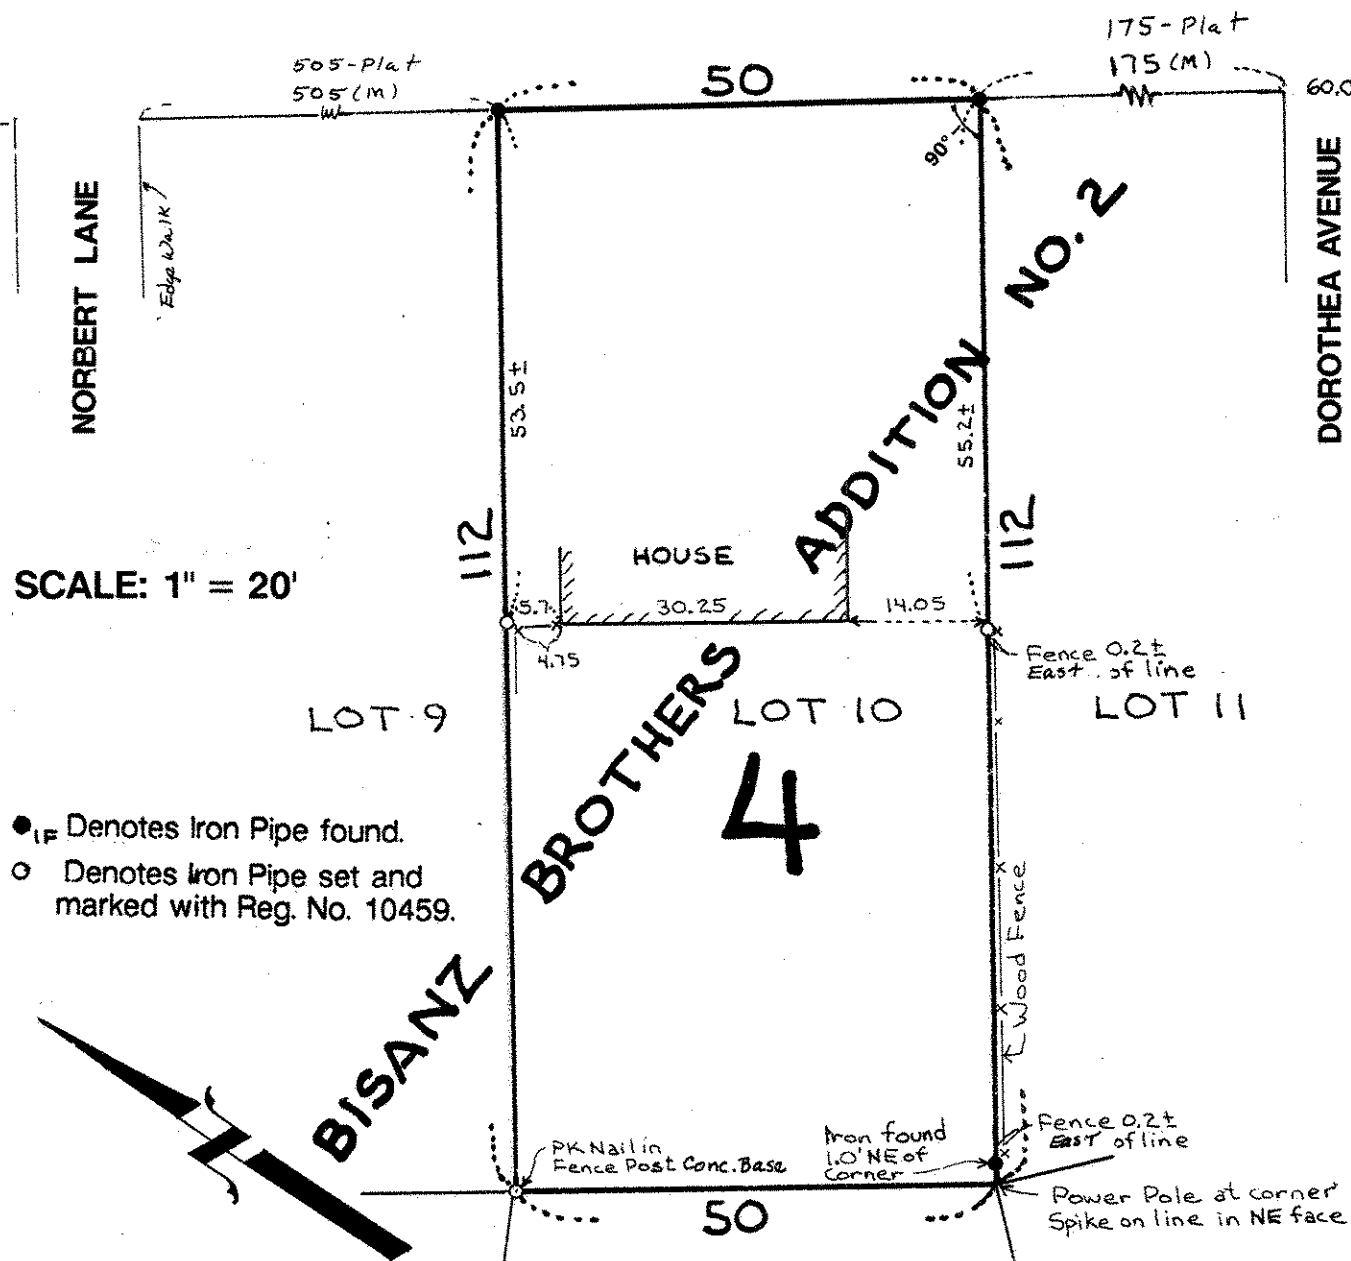

- IP Denotes Iron Pipe found.
- Denotes Iron Pipe set and marked with Reg. No. 10459.

I hereby certify that this survey, plan plat, preliminary plat or report was prepared by me or under my direct supervision and that I am a duly Registered Land Surveyor under the laws of the State of Minnesota.

Donald W. Schmidt 10459
Reg. No.

8/5/92
Date

R-92832
Job No.

Book No.