SW 16 28 23

Certificate of Survey

From the office of

GEORGI- SCHMIDT & ASSOC. INC.

3092 No. Lexington Ave., Roseville, Mn. 55113

LAND SURVEYING

483-4408

I Hereby Certify that this plat shows a survey made by me of the property described on this plat, and that the corners are correctly placed as shown, and that all locations have been correctly shown.

Job Number: 68

Surveyed For Aron Frieberg

Date July 31, 1978

Scale 1" = 20'

By Donald W Schmidt
REGISTERED LAND SURVEYOR

Description:

Lot 10, Block ~~2~~ 4, Bisanz Brother's Addition No. 2
 
Ramsey County, Mn.