

LOTS 7 & 8 BLOCK 6

BOULEVARD ADD.

No. 3,


JOHN B. IRVINE, SURVEYOR.

408 GLOBE BLDG.

ST. PAUL, MINN.

SEPT 3-1914

SELBY AVE.

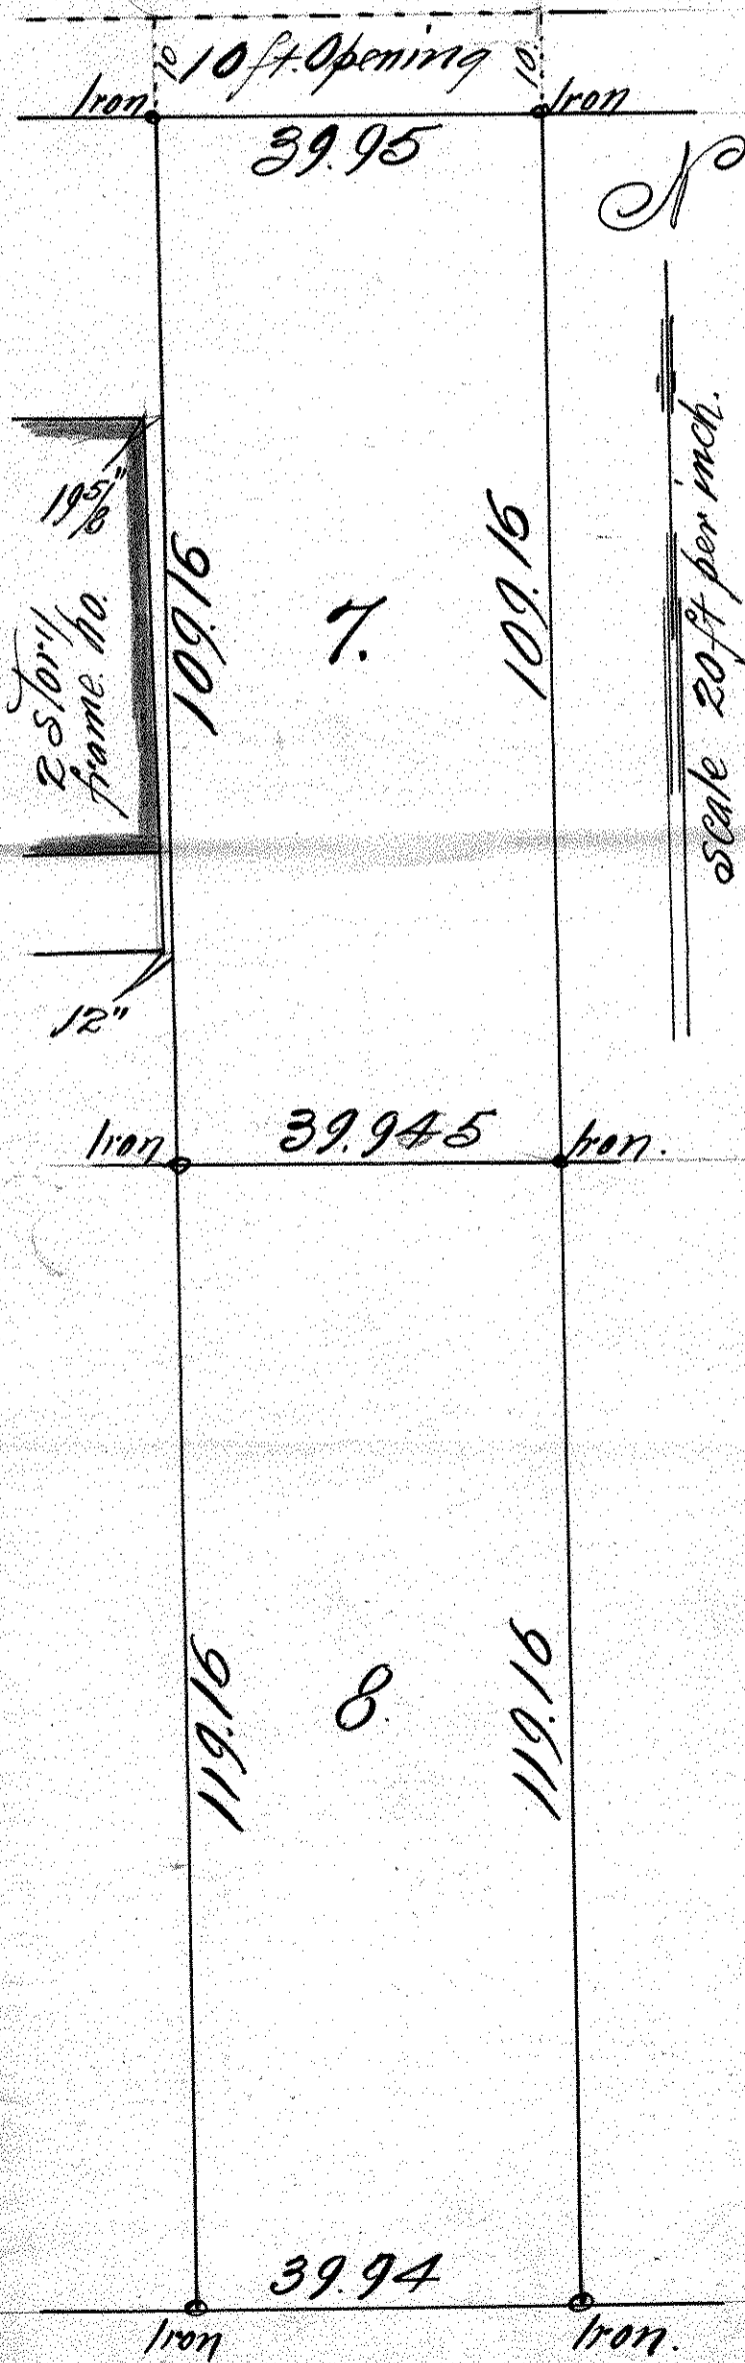

HAGUE AVE.