LOTS 13 & 14 BLOCK 2
BOULEVARD ADD.
NO. 3.
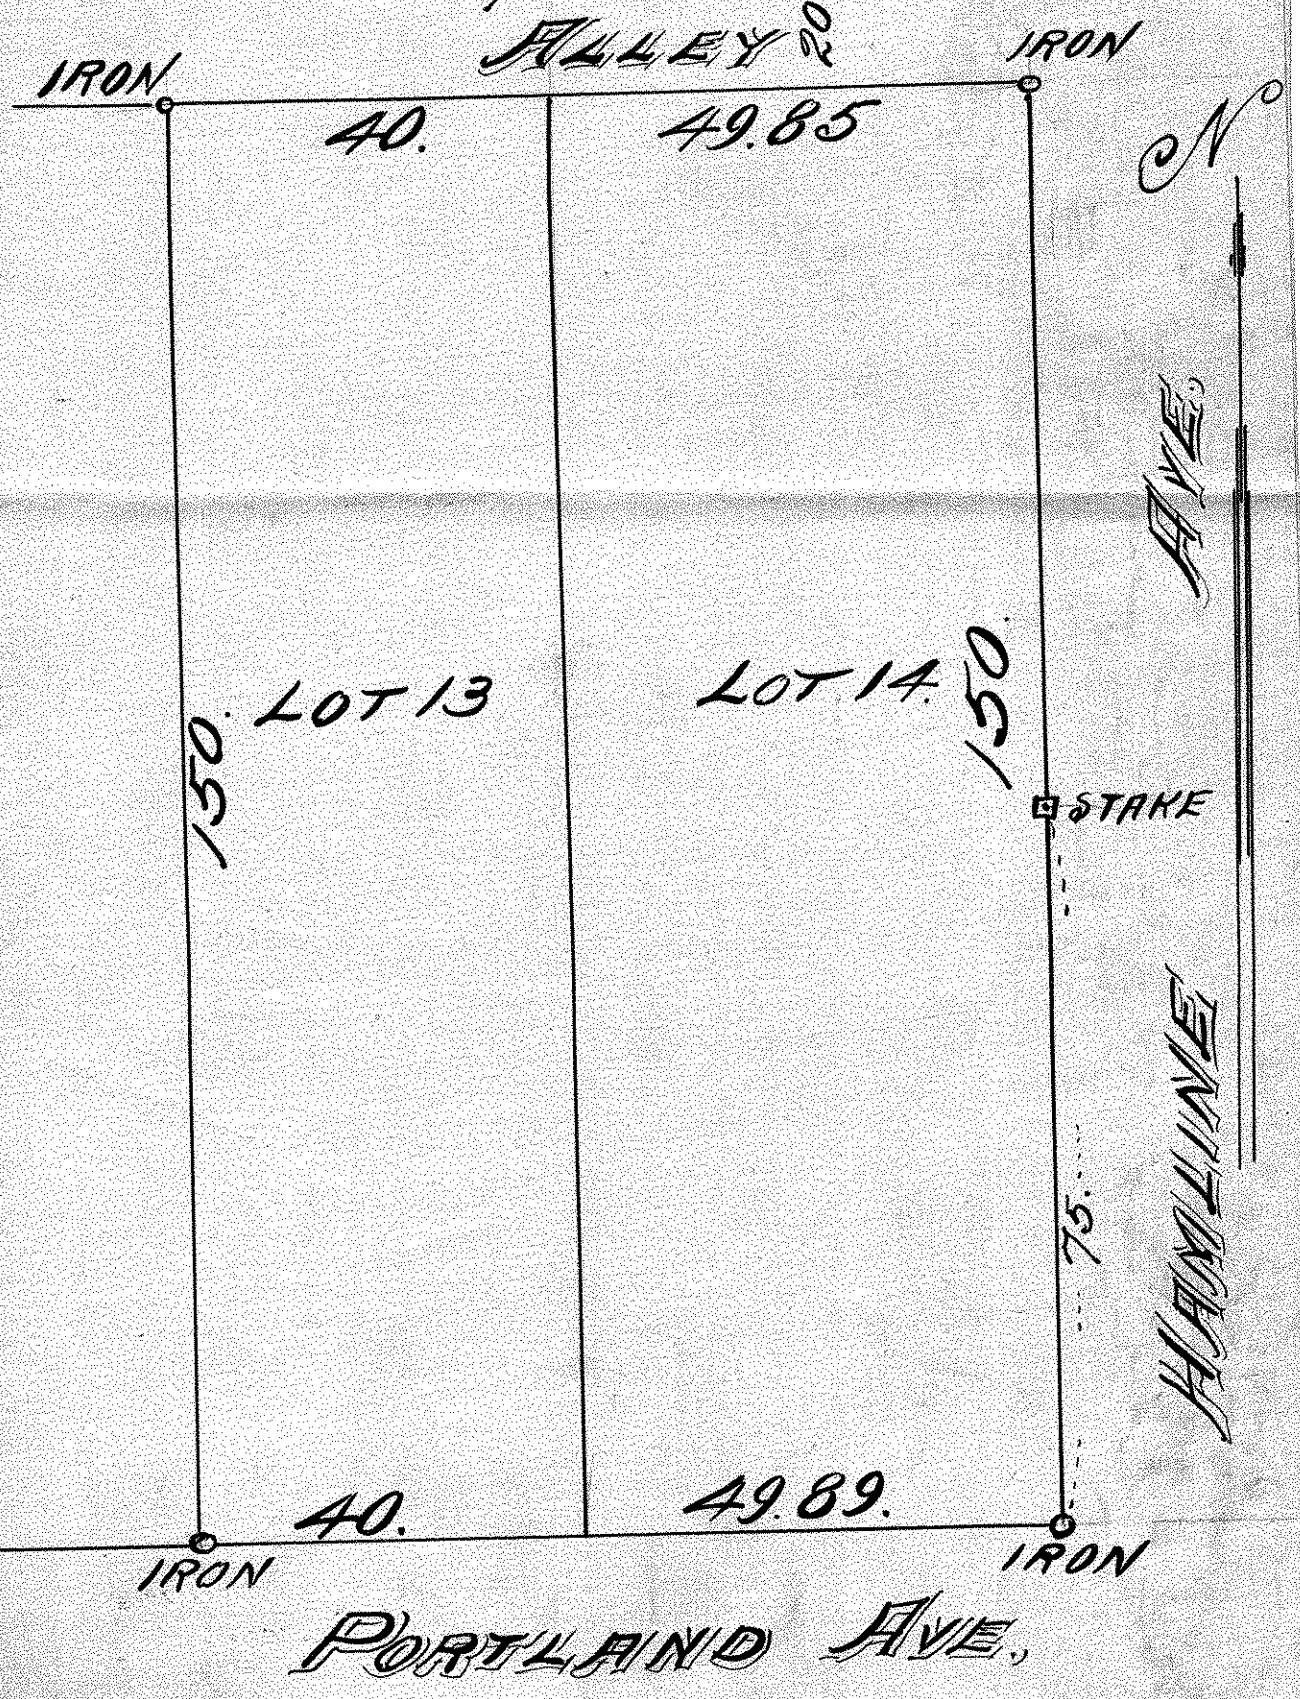
JOHN B. IRVINE, SURVEYOR.
408 GLOBE BLD'G.
ST. PAUL, MINN.
SEPT. 29 1909
SCALE 20 ft. per inch.