
## PLAT OF SURVEY

OF PROPERTY OF Bernard J. Weiss.
DESCRIBED AS FOLLOWS Lot 13, Block 16, Boulevard Addition No. 2
No. 1375 Ashland Ave St. Paul, Minn.

SCALE: 1 INCH 30 FEET

T. J. WELCH, REGISTERED SURVEYOR 738 SURREY AVENUE, ST. PAUL, MINN.

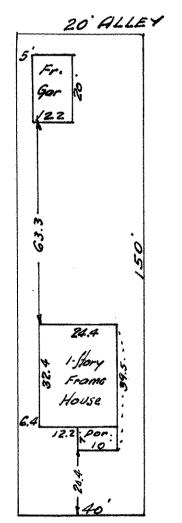

ASHLAND AVE.



CERTIFICATE OF SURVEY

I hereby certify that on July 13 1944.

I surveyed the property described above and that the above

J. J. Welel