

FROM THE OFFICE OF

# CHARLES O. GEORGI COMPANY

2215 West County Road B

Saint Paul, Minnesota 55113

REGISTERED CIVIL ENGINEER AND LAND SURVEYOR



I Hereby Certify that this plat shows a survey made by me of the property described on this plat, and that the corners are correctly placed as shown, and that all locations have been correctly shown.

Surveyed For Richard Coverdale


Date June 1975

Scale 1"=40'

By Charles O. Georgi  
REGISTERED LAND SURVEYOR

**Description:**

Lot 12  
Block 6  
Boulevard Addition No. 3  
Ramsey County, Minn.

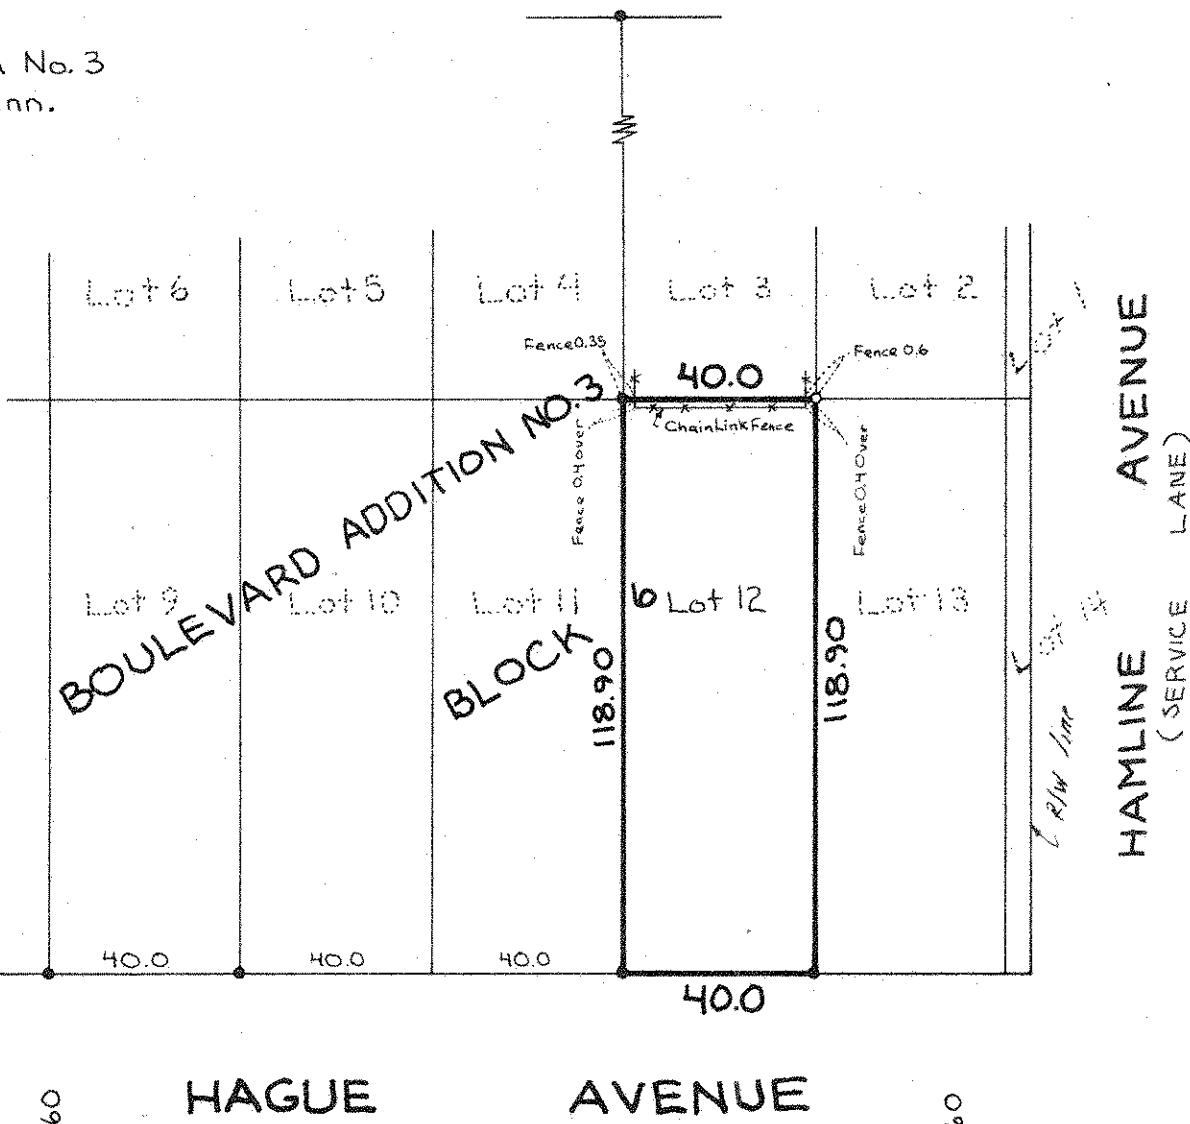

○ Denotes Iron Monument  
● Denotes Iron Monument found in place