

Appl. No. 20954

TELEPHONE TOWER 0640

# PLAT OF SURVEY

OF PROPERTY OF Harold E. Davis


DESCRIBED AS FOLLOWS Lot 10, Block 3, Boulevard Addition No. 3.

No. 1341 Ashland Ave - St Paul, Minn.

SCALE: 1 INCH 30 FEET

T. J. WELCH, REGISTERED SURVEYOR  
738 SURREY AVENUE, ST. PAUL 6, MINN.

20'- ALLEY

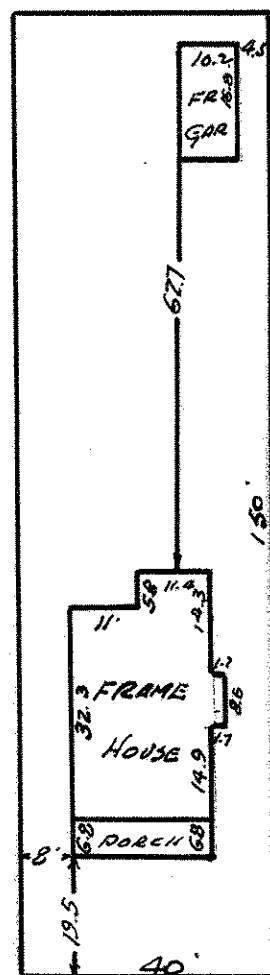

ASHLAND AVE.

## CERTIFICATE OF SURVEY

I hereby certify that on 7-24 1954

I surveyed the property described above and that the above  
plat is a correct representation of said survey.

T. J. Welch.