


# PLAT OF SURVEY

OF PROPERTY OF David W. Cunningham.

DESCRIBED AS FOLLOWS Lot 11 Block 2 Boulevard Addition No 3.  
No. 1355 Portland Avenue St. Paul.

SCALE: 1 INCH 30 FEET.

T. J. WELCH, REGISTERED SURVEYOR  
738 VAN BUREN PLACE, ST. PAUL, MINN.

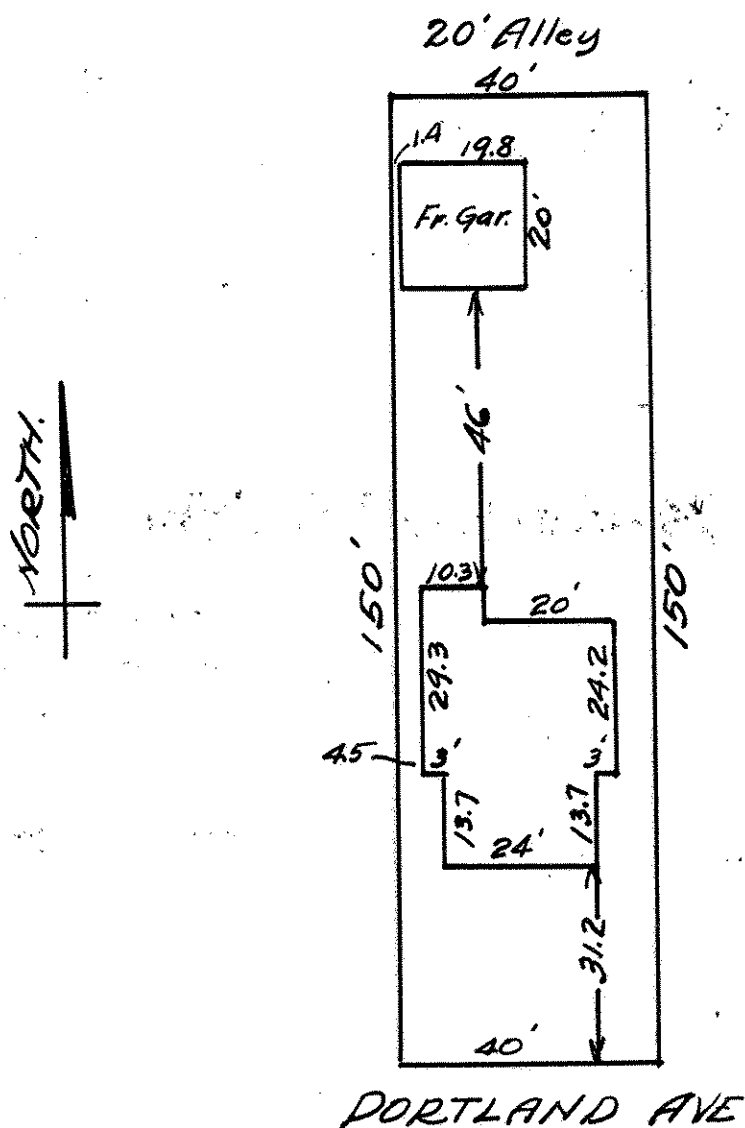

## CERTIFICATE OF LOCATION OF BUILDING

I hereby certify that on May 22 1939  
I made a survey of the location of the building on the above  
described property and that the location of said building is  
correctly shown on the above plat.

T. J. Welch

## CERTIFICATE OF SURVEY

I hereby certify that on May 22 1939  
I surveyed the property described above and that the above  
plat is a correct representation of said survey.

T. J. Welch