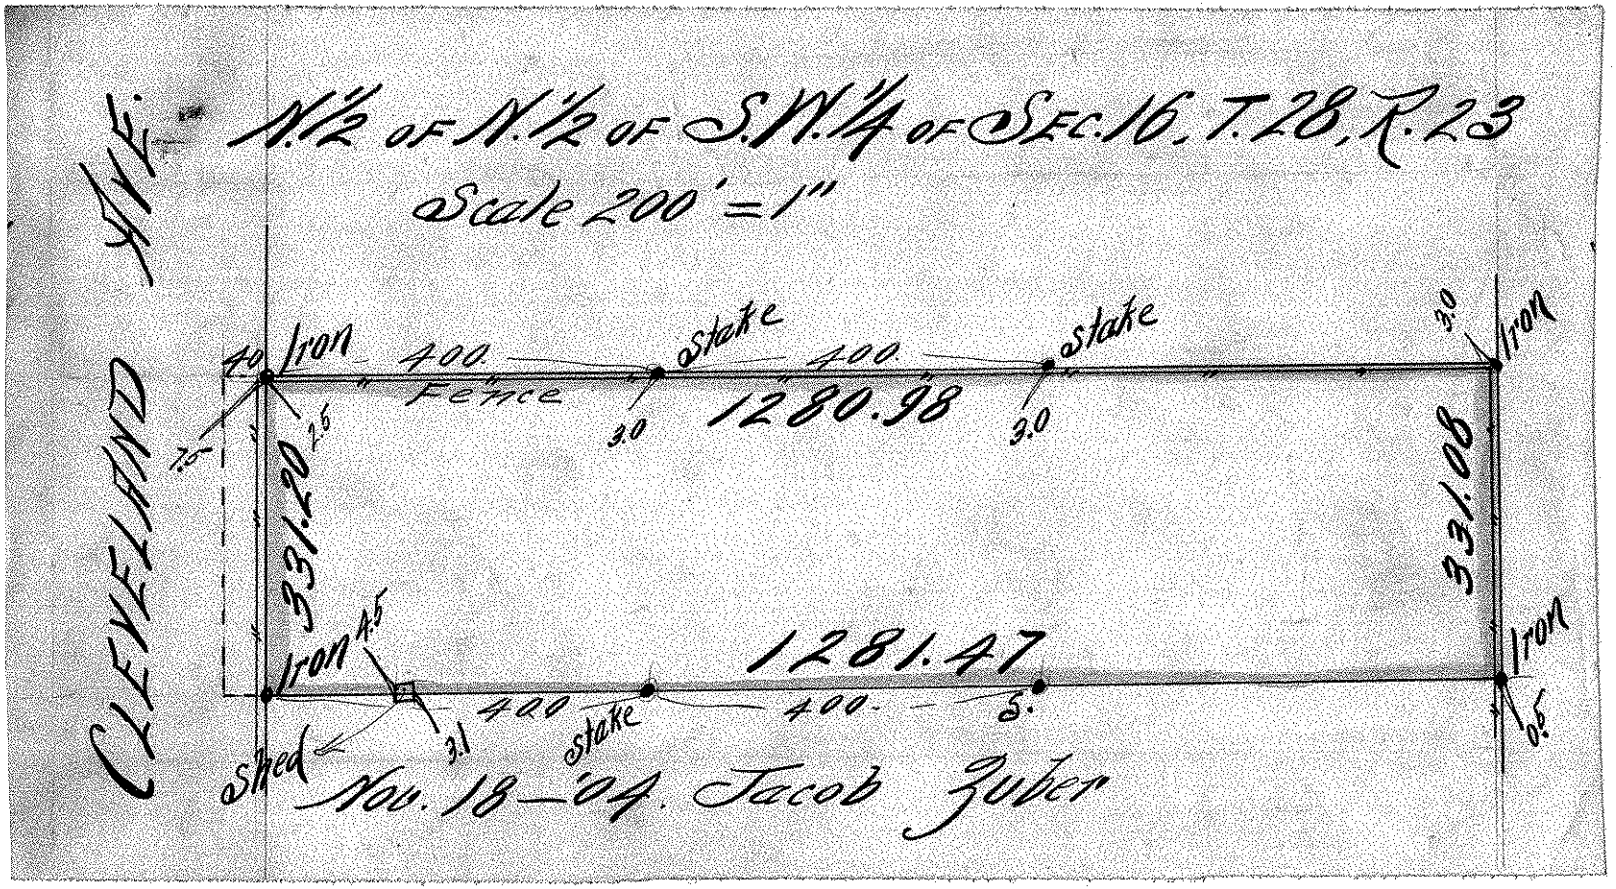
N.½ of N.½ of S.W.¼ of Sec. 16, T. 28, R. 23
Scale 200' = 1"
Cleveland Ave.
Iron
400
Fence
stake
400
stake
1280.98
3.0
3.0
3.0
Iron
331.20
331.00
Iron
4.5
1281.47
Iron
Shed
3.1
400
stake
400
5.
0.5
Nov. 18—04. Jacob Zuber