No

WEST 1/2 EAST 1/2 N.W. 1/4. S.W. 1/4. SECTION 16 TOWN 28. RANGE 23.

JOHN B. IRVINE, SURVEYOR.
408 GLOBE BLD'G.
ST. PAUL, MINN.
SEPT 3-1914
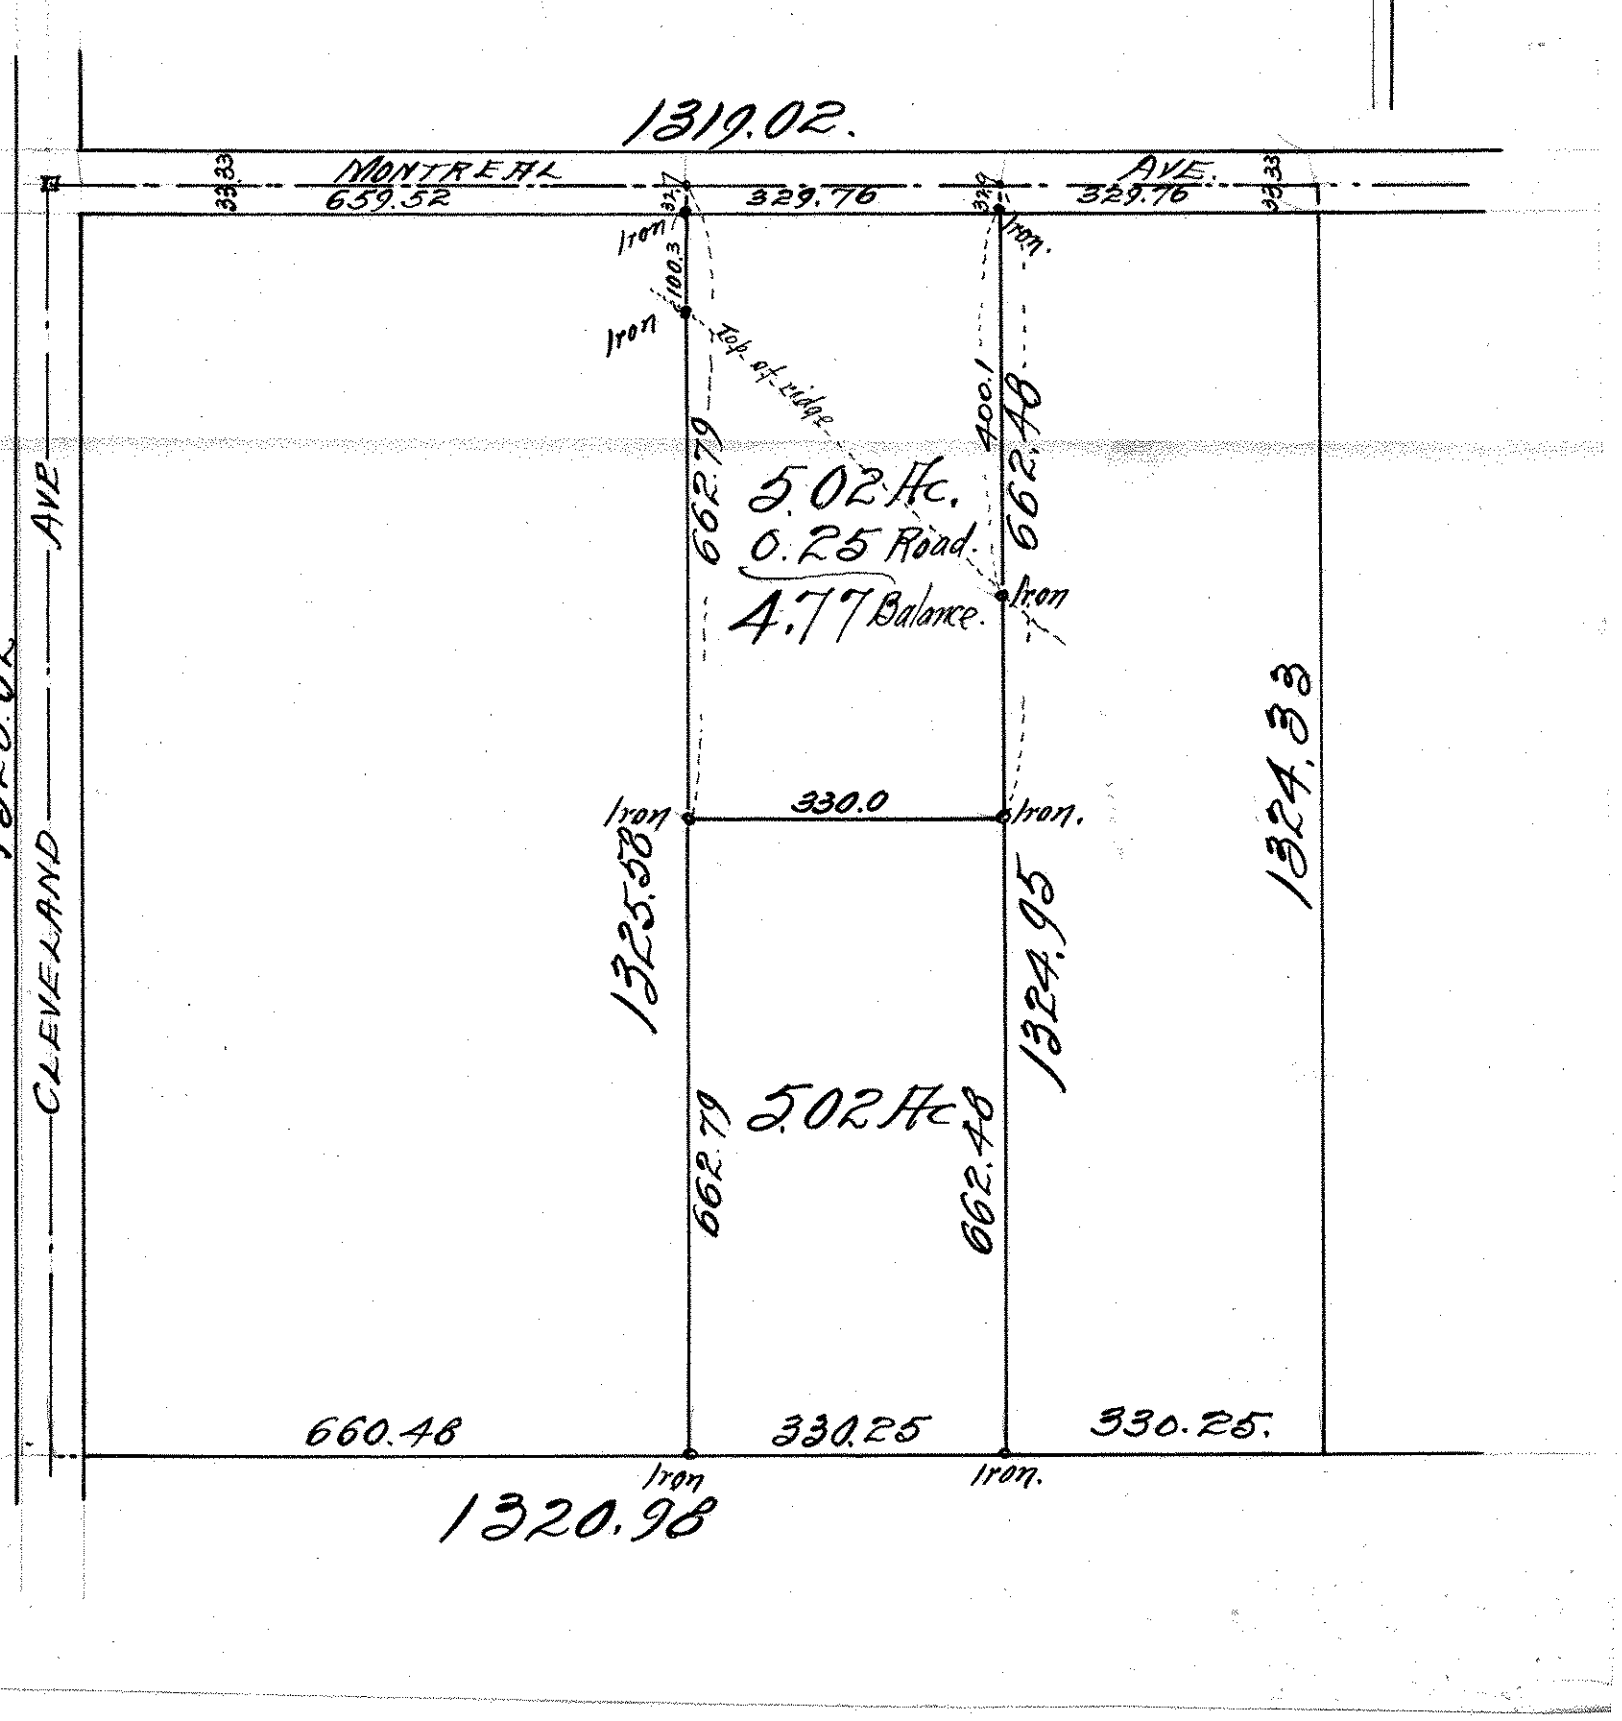
Scale 200 ft. per. inch.