

LOT 32 FRANKLIN STEELES SUB. OF LOT 2  
SEC. 21, T. 28, R. 23

SUR. May 5<sup>th</sup> '03 Geo. Harris


100' = 1"

UNION ST.

W. 7<sup>TH</sup> ST.  
Fort Smelting Hotel

MISSISSIPPI AVE  
Stake 100. Stake 170. Stake 22.17 Stake 363

STONE ARCH N. END BRIDGE  
10' = 1"

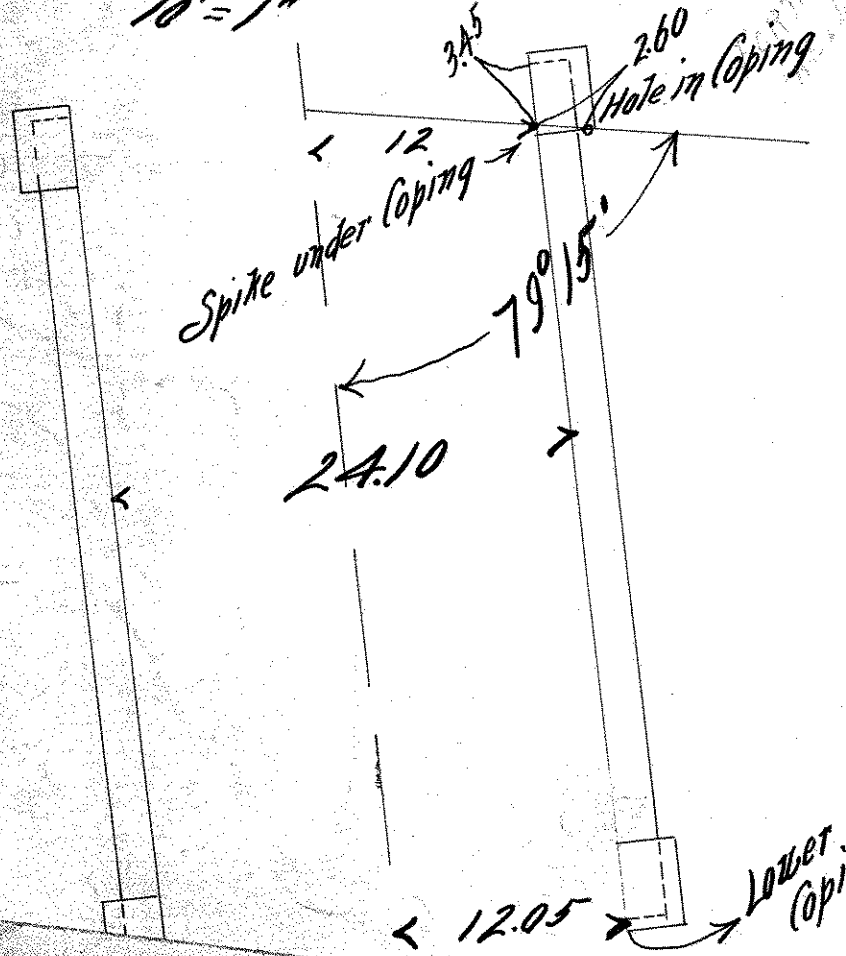

Fort Smelting Bridge



Lot 32

Sand Bar

MISSISSIPPI RIVER

