MISCELLANEOUS TRACT
BETWEEN
E.G. HANDY'S & SCHROEDER'S ADD'S.
N.E. 1/4 SEC. 4. TOWN 28 RANGE 23.

JOHN B. IRVINE, SURVEYOR
408 GLOBE BLD'G.
ST. PAUL, MINN.
JUNE 24-1914
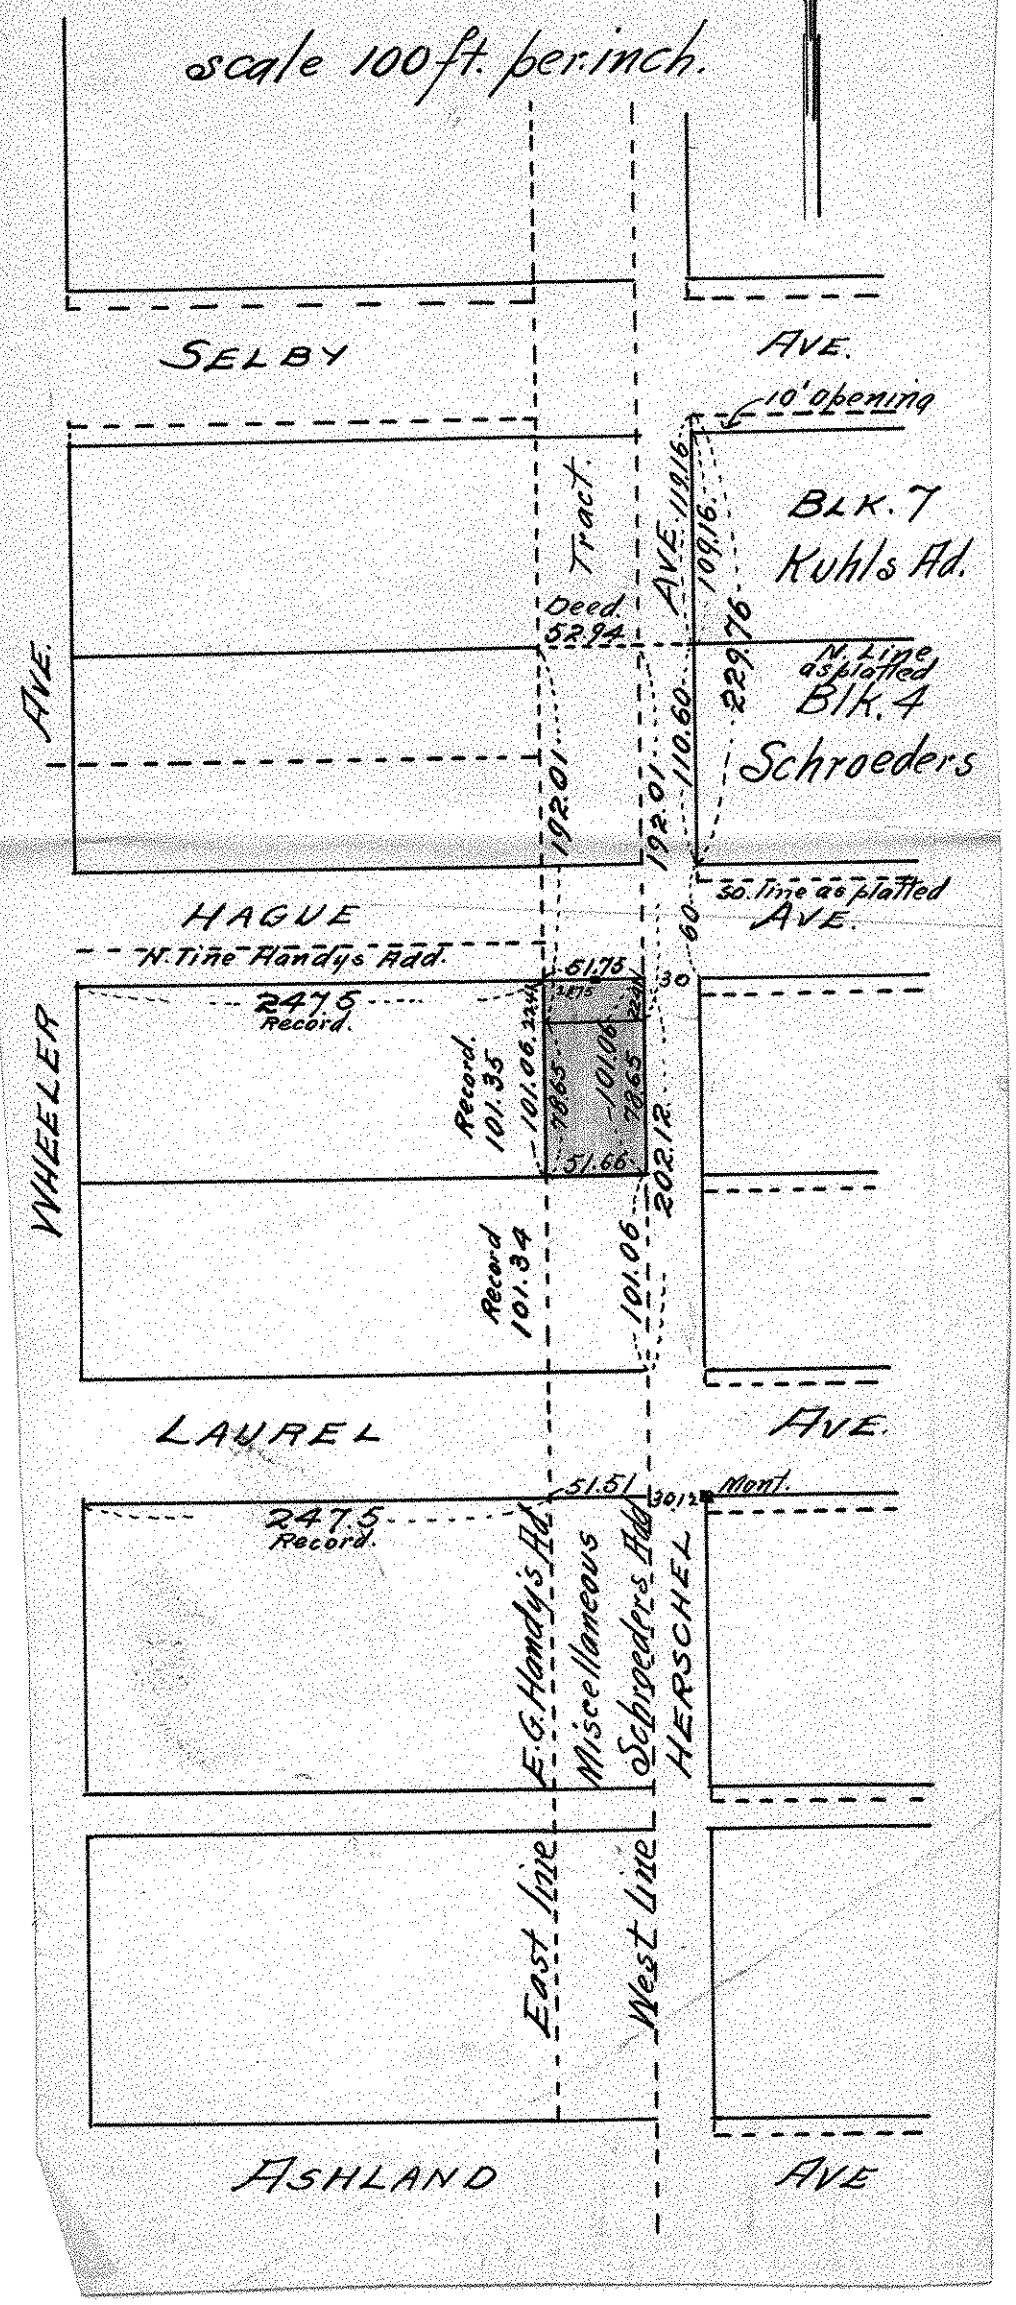
scale 100 ft. per inch.