


LOT 28, BLK. 2.  
E. G. HANDY'S ADD.

JOHN B. IRVINE, SURVEYOR.

JULY 23-1908.

SCALE 20ft. per inch.

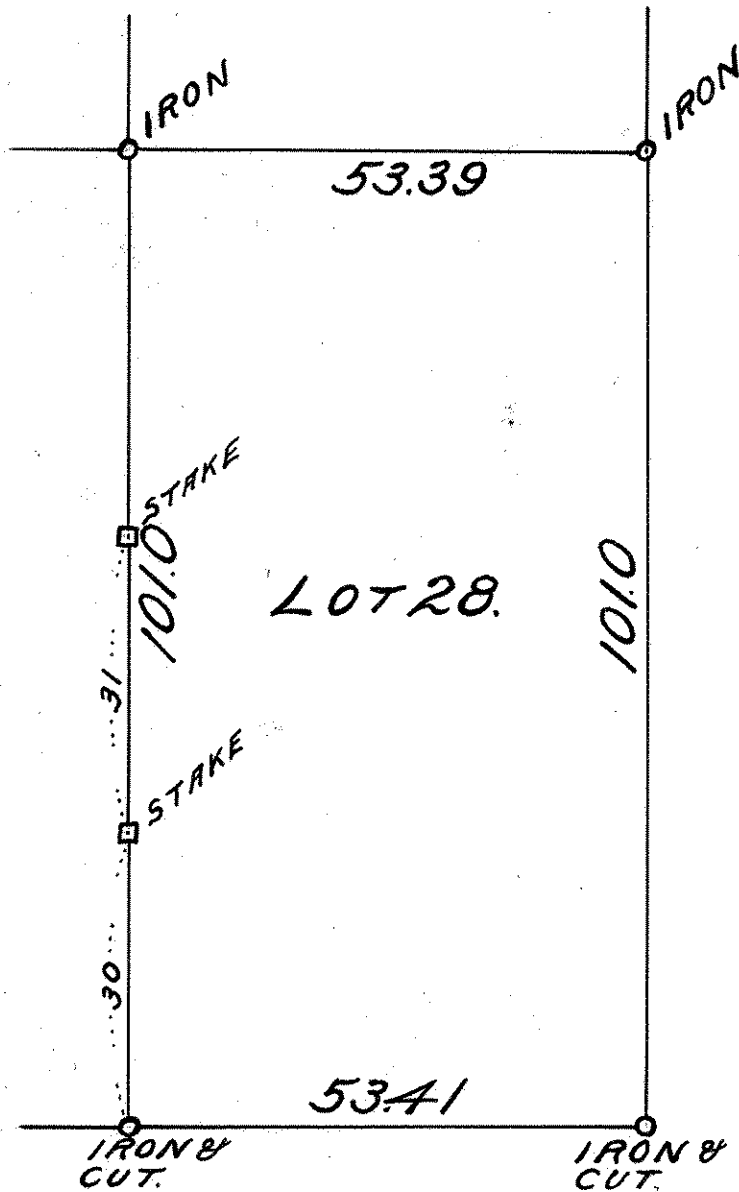

LAUREL AVE.