

LOT 23 BLOCK 3
E.G. HANDY'S ADD.

JOHN B. IRVINE, SURVEYOR.


ST. PAUL, MINN.

APRIL 23-1919.

JUNE 9-1919.

Scale 20 ft. per inch.

ALLEY

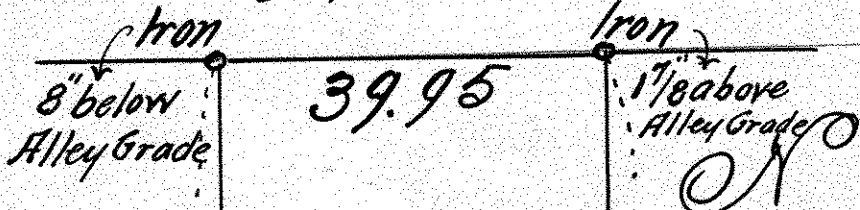


LOT 23

80 86

150.

150.

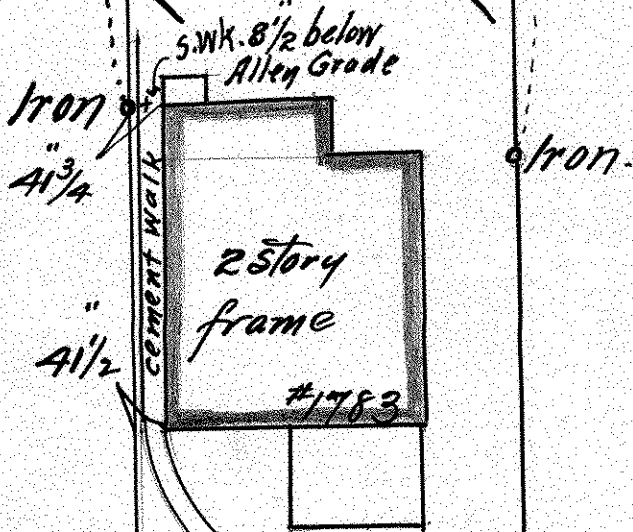

39.96



ASHLAND AVE.