


LOT 6 & WEST 14 FT. OF LOT 7,  
BLOCK 1 HALLER'S ADD.

JOHN B. IRVINE SURVEYOR.  
ROOM 406. GLOBE BLDG.  
ST PAUL MINN.  
MARCH 24-06.

SCALE 1 IN. = 20 FT.

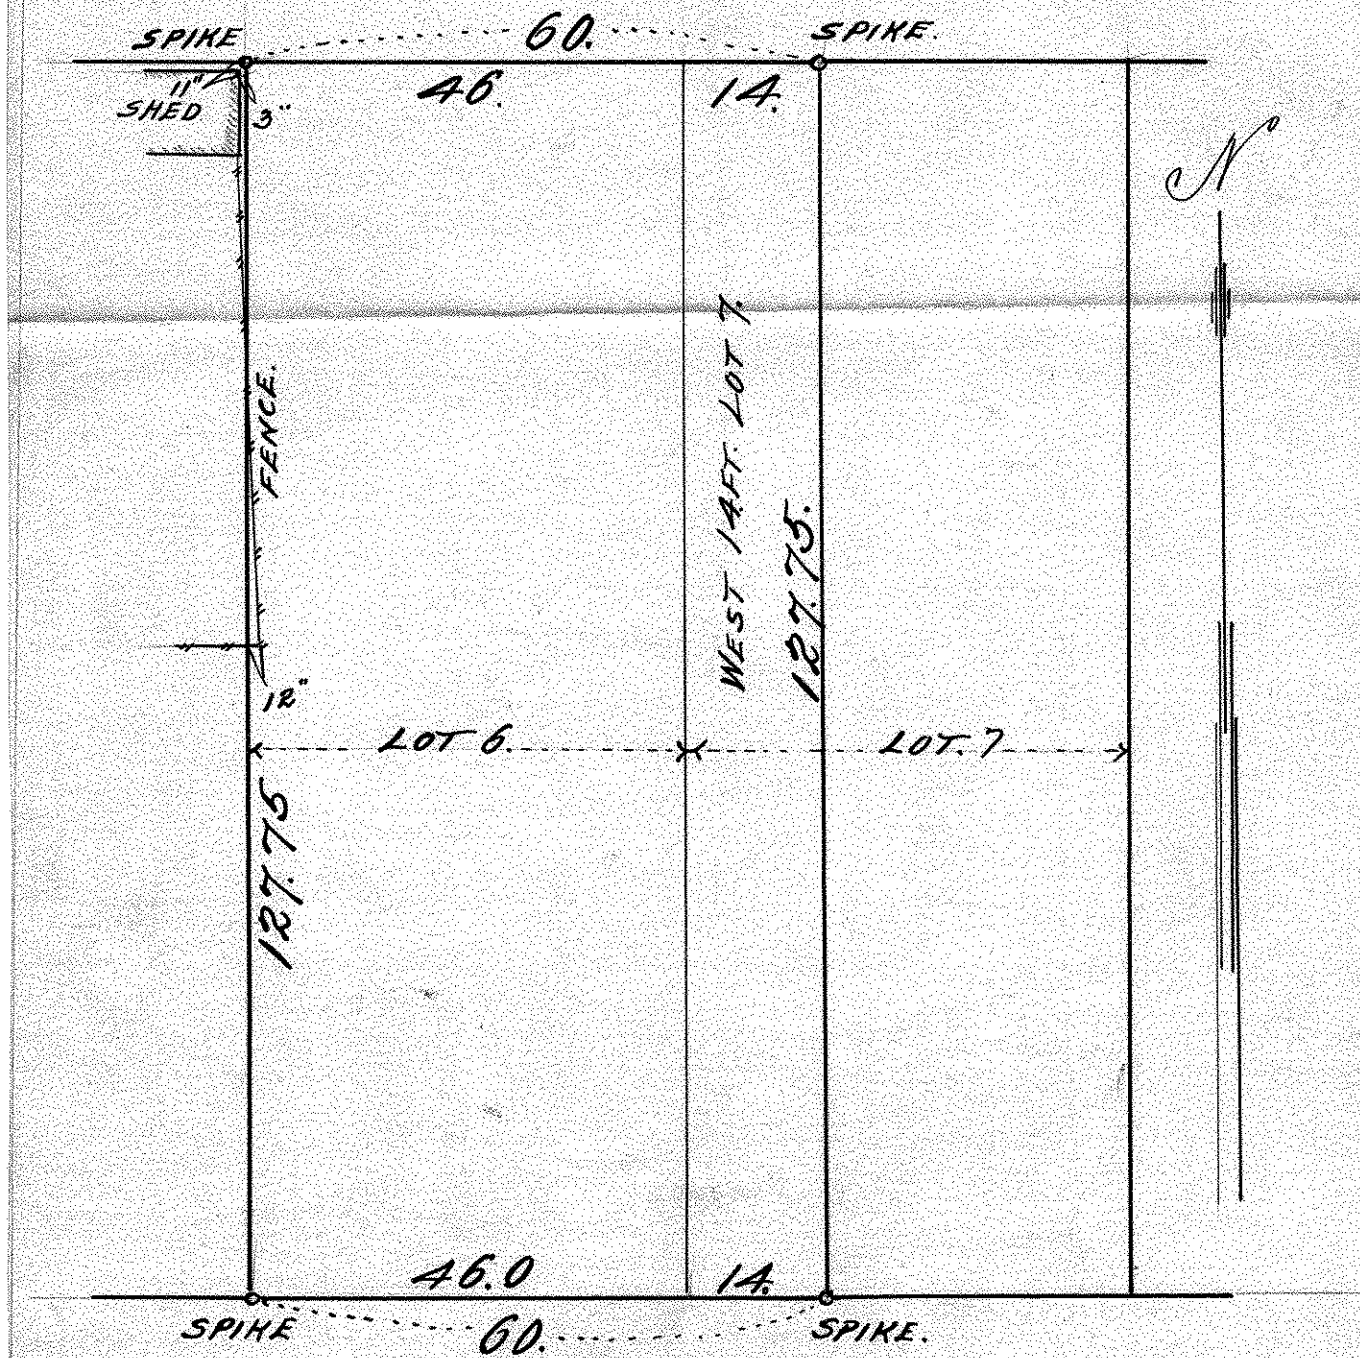

DAYTON AVE,  
658.9 City V. To MILTON.