


LOT 1, BLOCK 2  
HALDENMAN'S ADD.

Surveyed June 18<sup>th</sup> 1902  
scale 20 feet pr inch

GOODRICH AVE  
60

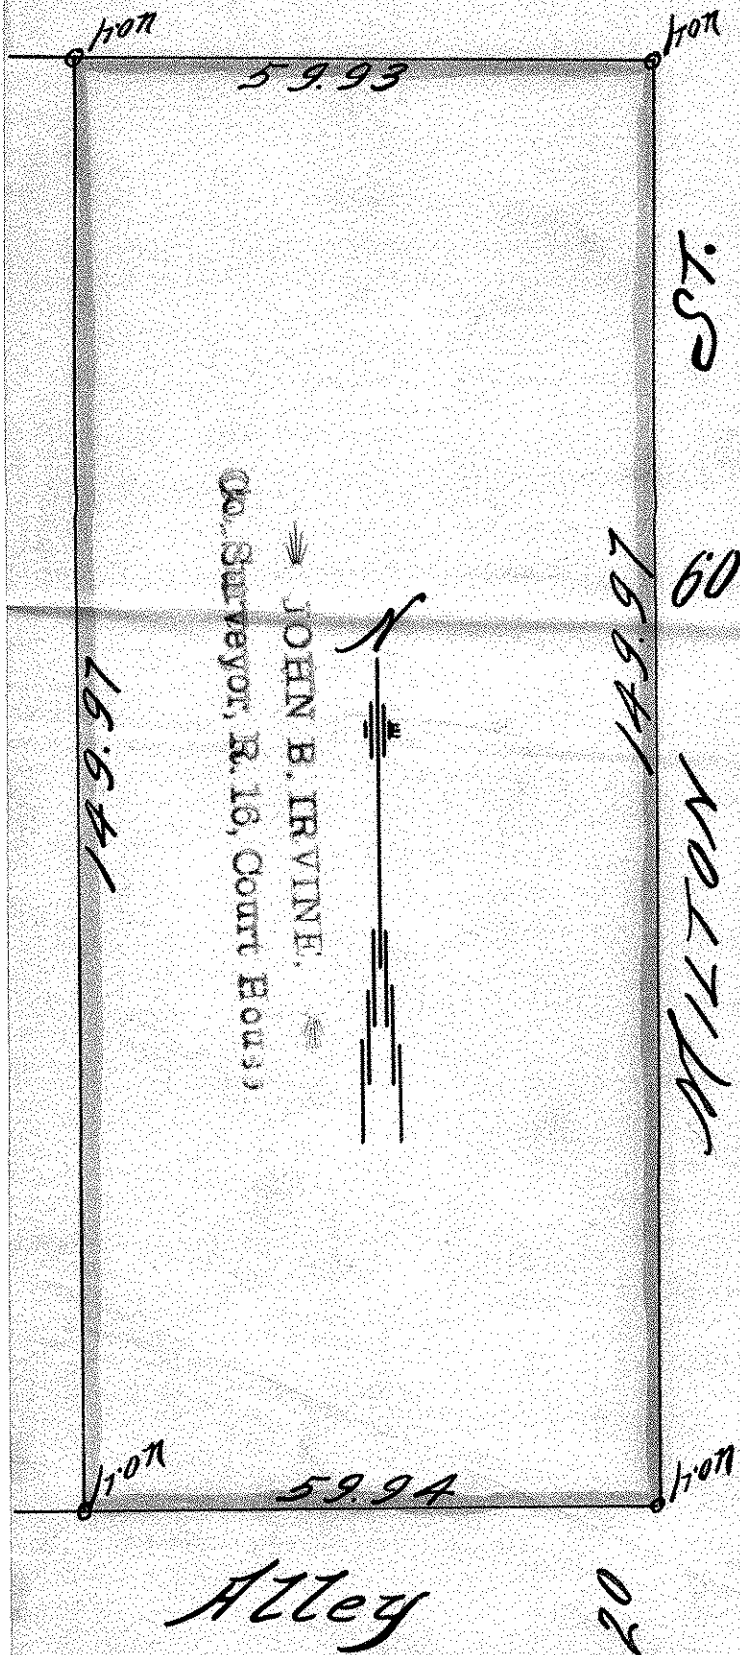

B47.P.26