


LOTS 11, 12, 13 & 14 BLOCK 2  
HALDEMAN'S ADD.

John B. Irvine, Surveyor.

Sept 24-1919.

Scale 20 ft. per. inch.

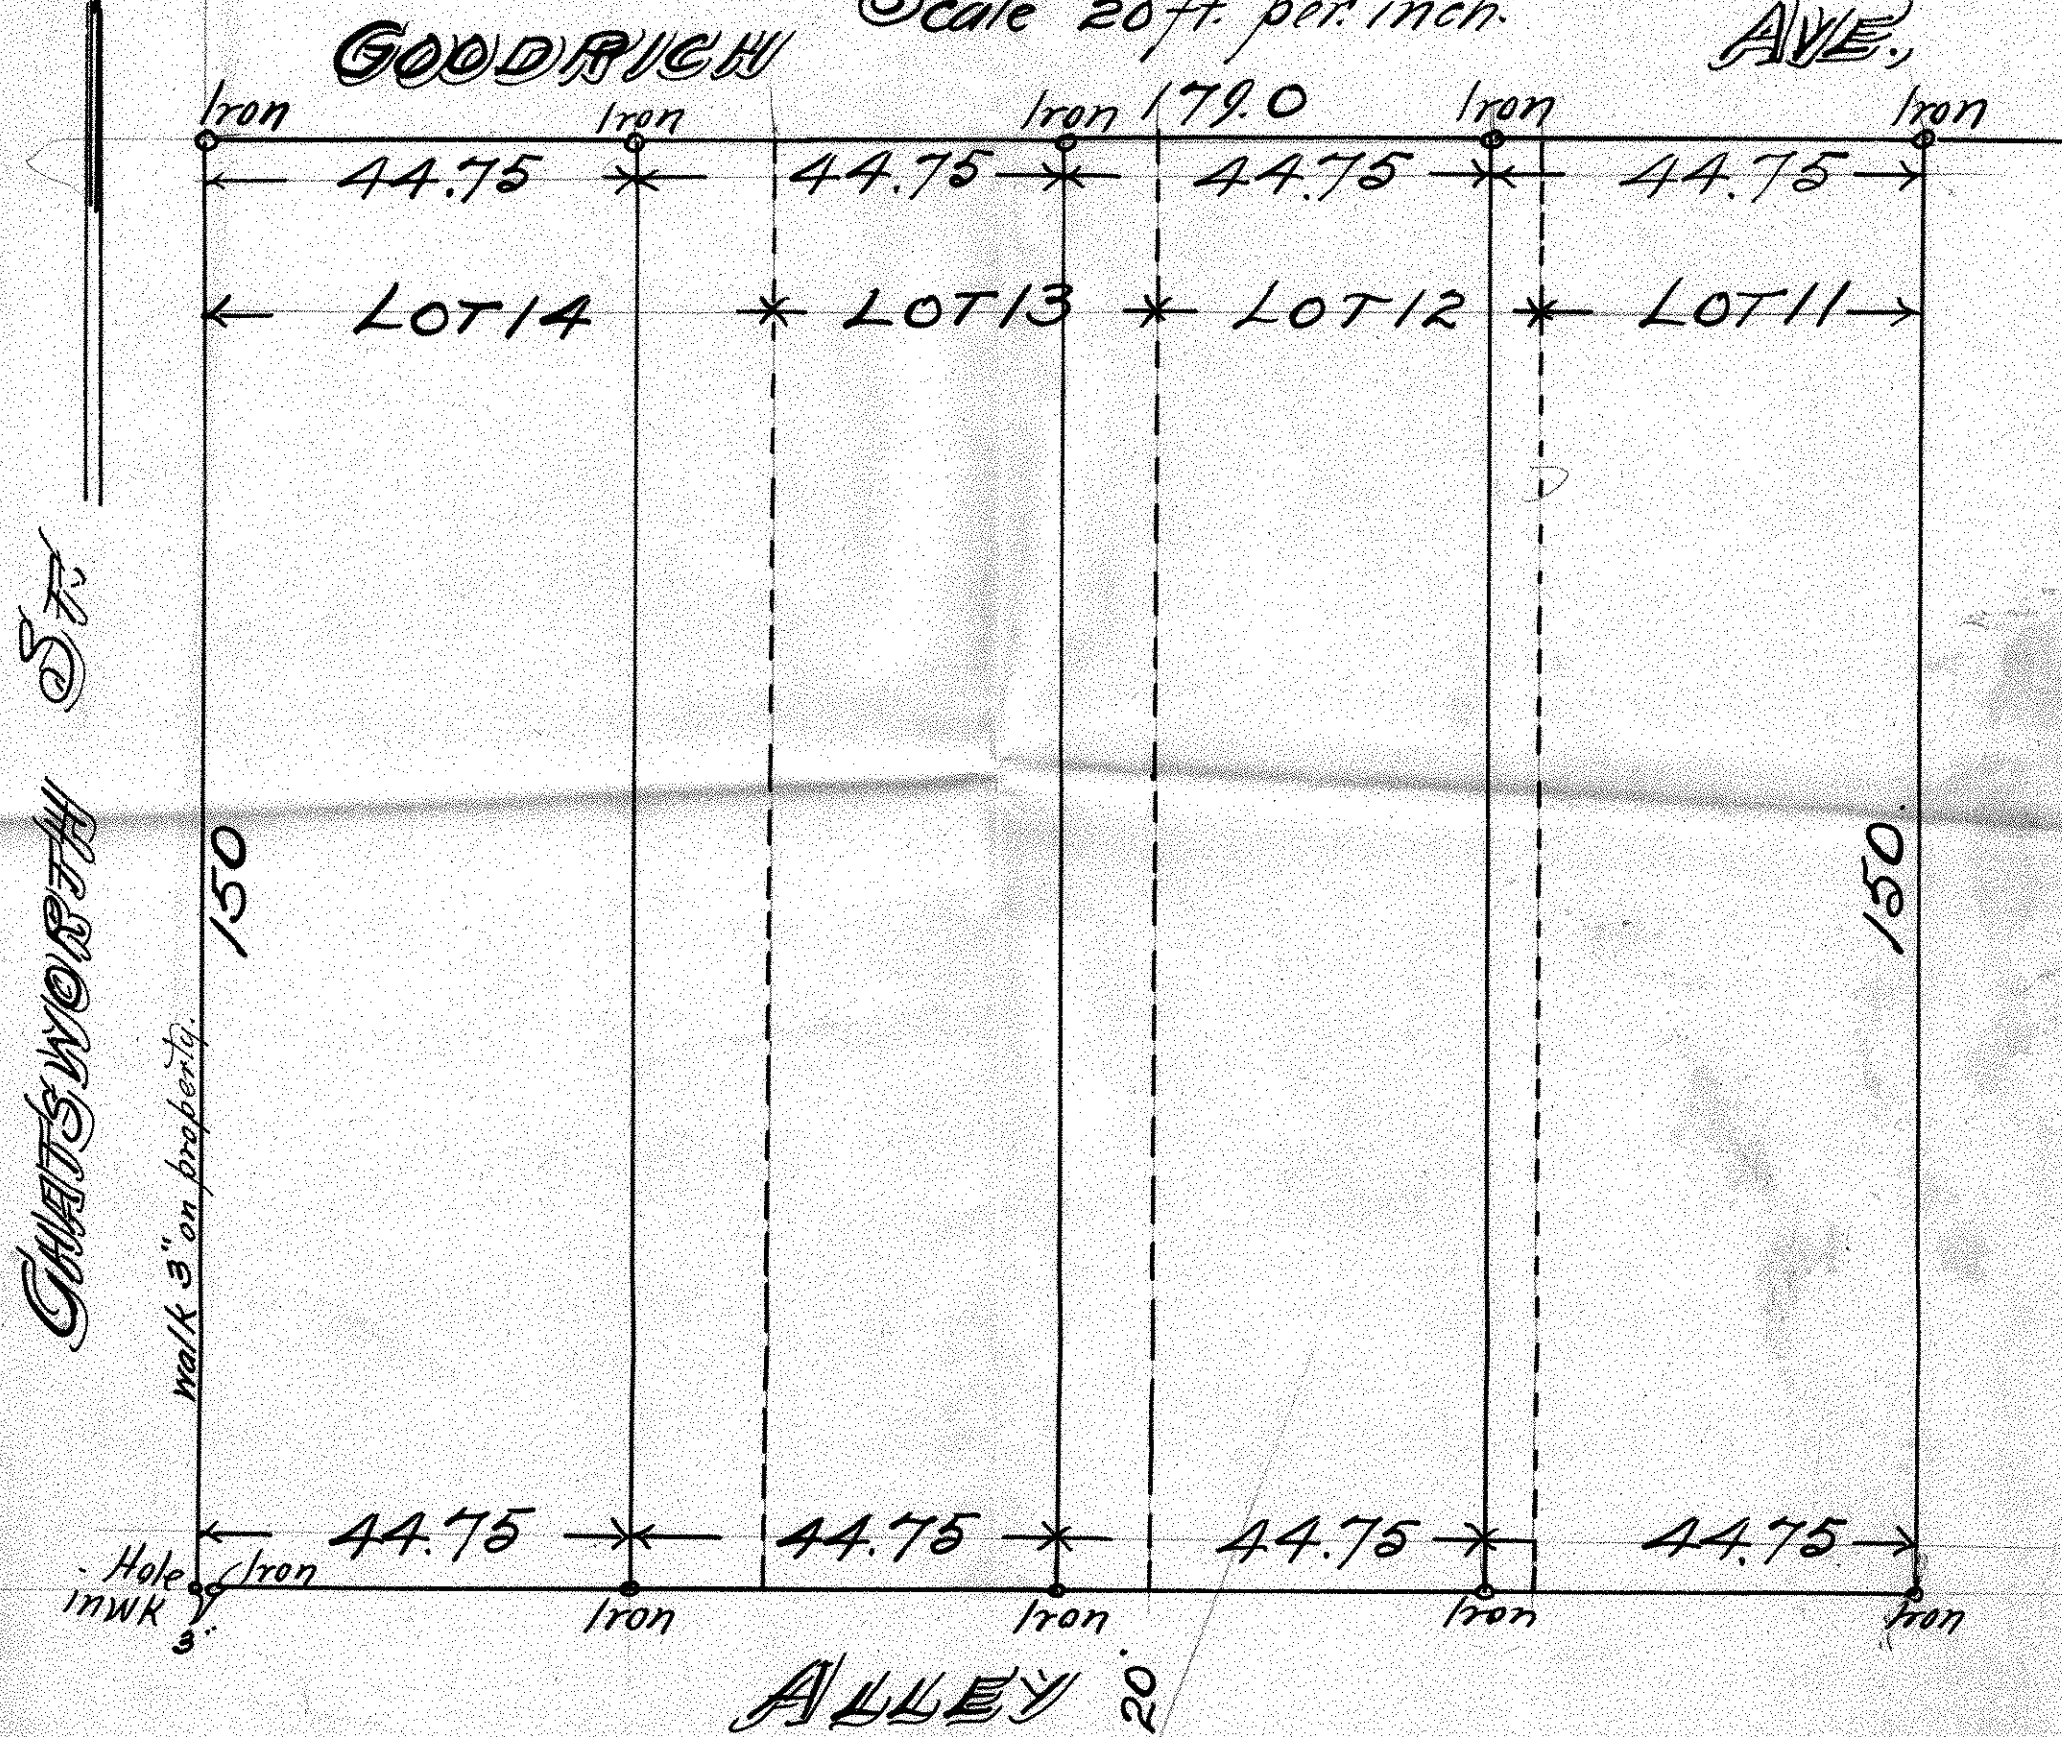

CHATS WORTH ST

walk 3" on property.

Hole in NW 3'

ALLEY 20'