

LOT 15 BLOCK 2.

HALDERMANS ADD.

SCALE 20 FT PER INCH

MARCH 13 - 1915


J. B. IRVINE.
SURVEYOR.
BY E. P. SCHAFER.

ALLEY.

ST.

CHATSWORTH

LOT 15.

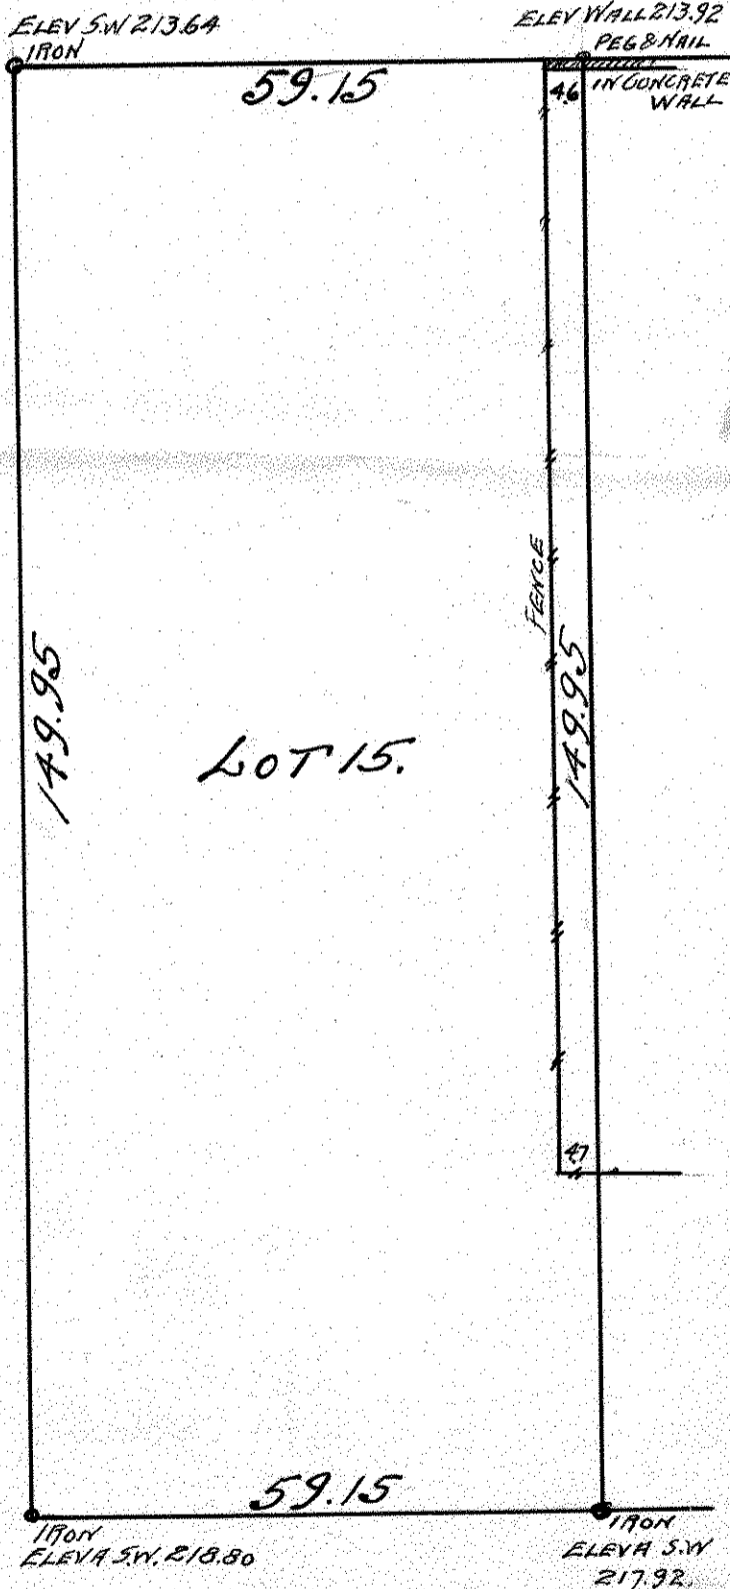

FAIRMOUNT AVE