

LOT 27 EXCEPT WEST 7 1/2 ft.  
&  
WEST 10 ft LOT 28 BLOCK 3


HILDENMAN'S ADD.

John B. Irvine, Surveyor.

Sept. 3-1920.

Scale. 20 ft. per inch.

ALLEY

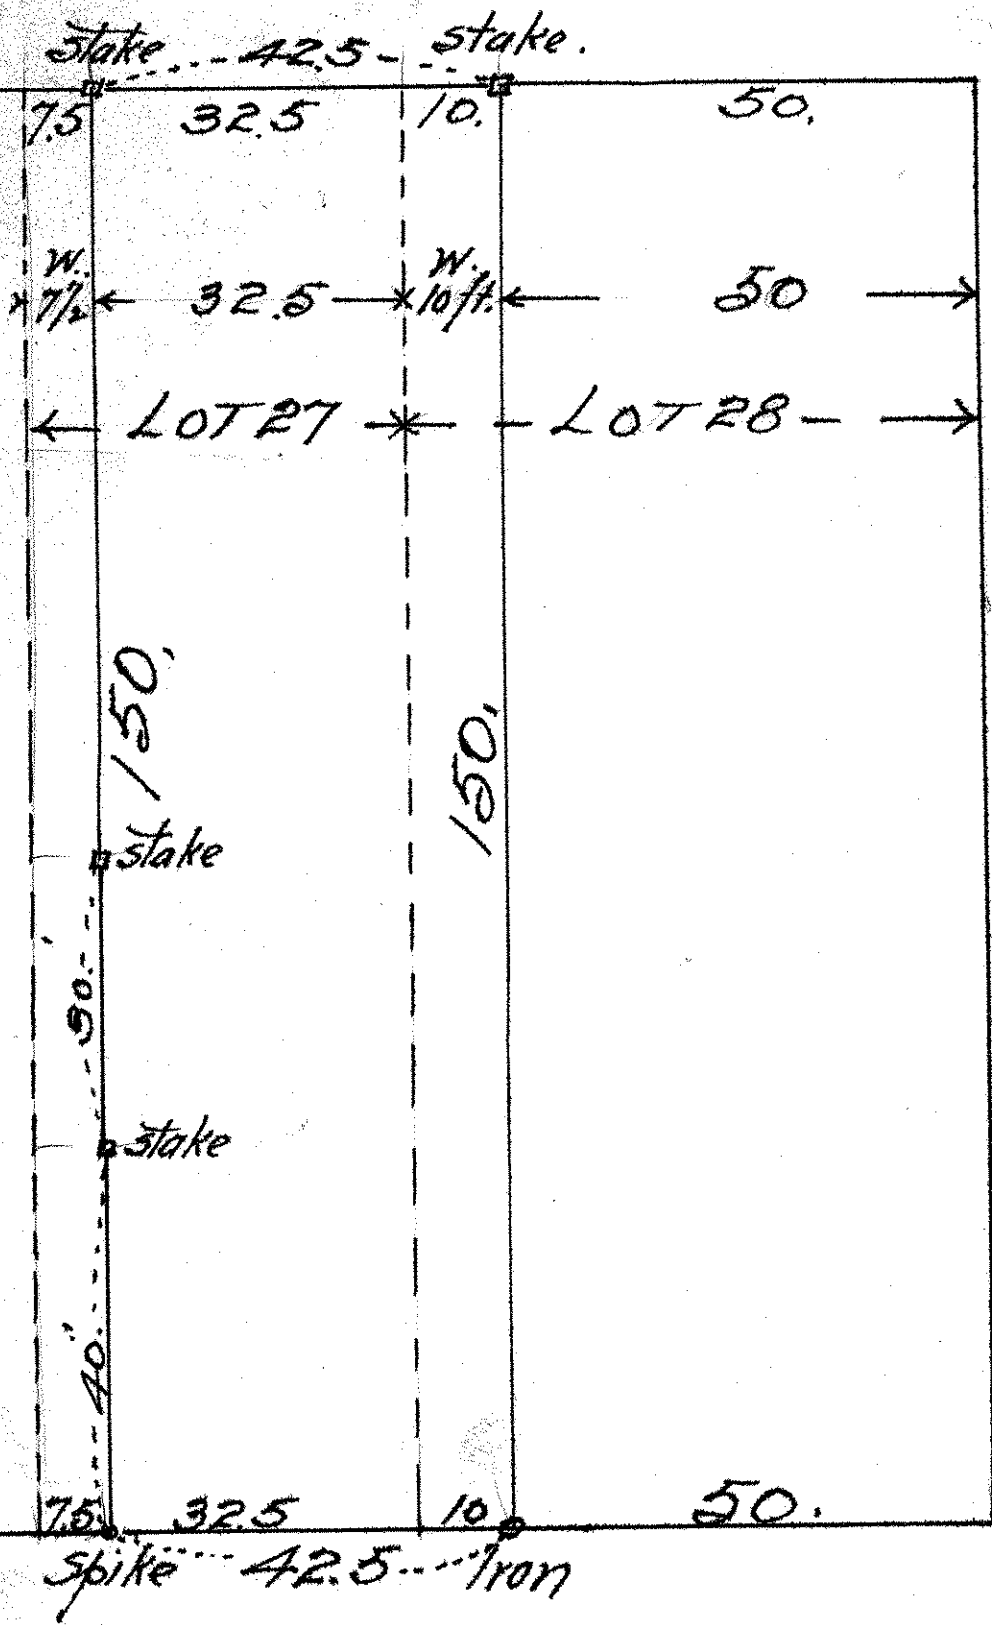

OSCEOLA AVE.