NE 21 28 23

Certificate of Survey

From the office of

GEORGI- SCHMIDT & ASSOC. INC.

3092 No. Lexington Ave., Roseville, Mn. 55113
LAND SURVEYING
483-4408

I Hereby Certify that this plat shows a survey made by me of the property described on this plat, and that the corners are correctly placed as shown, and that all locations have been correctly shown.

Job Number: 576
Surveyed For Jewish Community Center
Date February 1980
Scale 1"=20'

By Donald W. Schmidt
REGISTERED LAND SURVEYOR

DESCRIPTION:

That part of vacated Wheeler Street (Bellevue Avenue) which lies between Block 5 and 6, Granport Addition, and that part of Lots 15, 16 and 17, Block 5, Granport Addition and also that part of the vacated alley in said Block 5, Granport Addition described as follows:

Beginning at the Southeast corner of Lot 1, Block 6, said Granport Addition; thence South along the East line of said Block 6 a distance of 26.00 feet; thence East, parallel with the vacated alley in said Block 5, Granport Addition, a distance of 192.5 feet; thence North parallel with the West line of said Block 5 a distance of 26.00 feet to the North line of the vacated alley in said Block 5; thence West along said North line and its westerly extension a distance of 192.5 feet to the point of beginning.
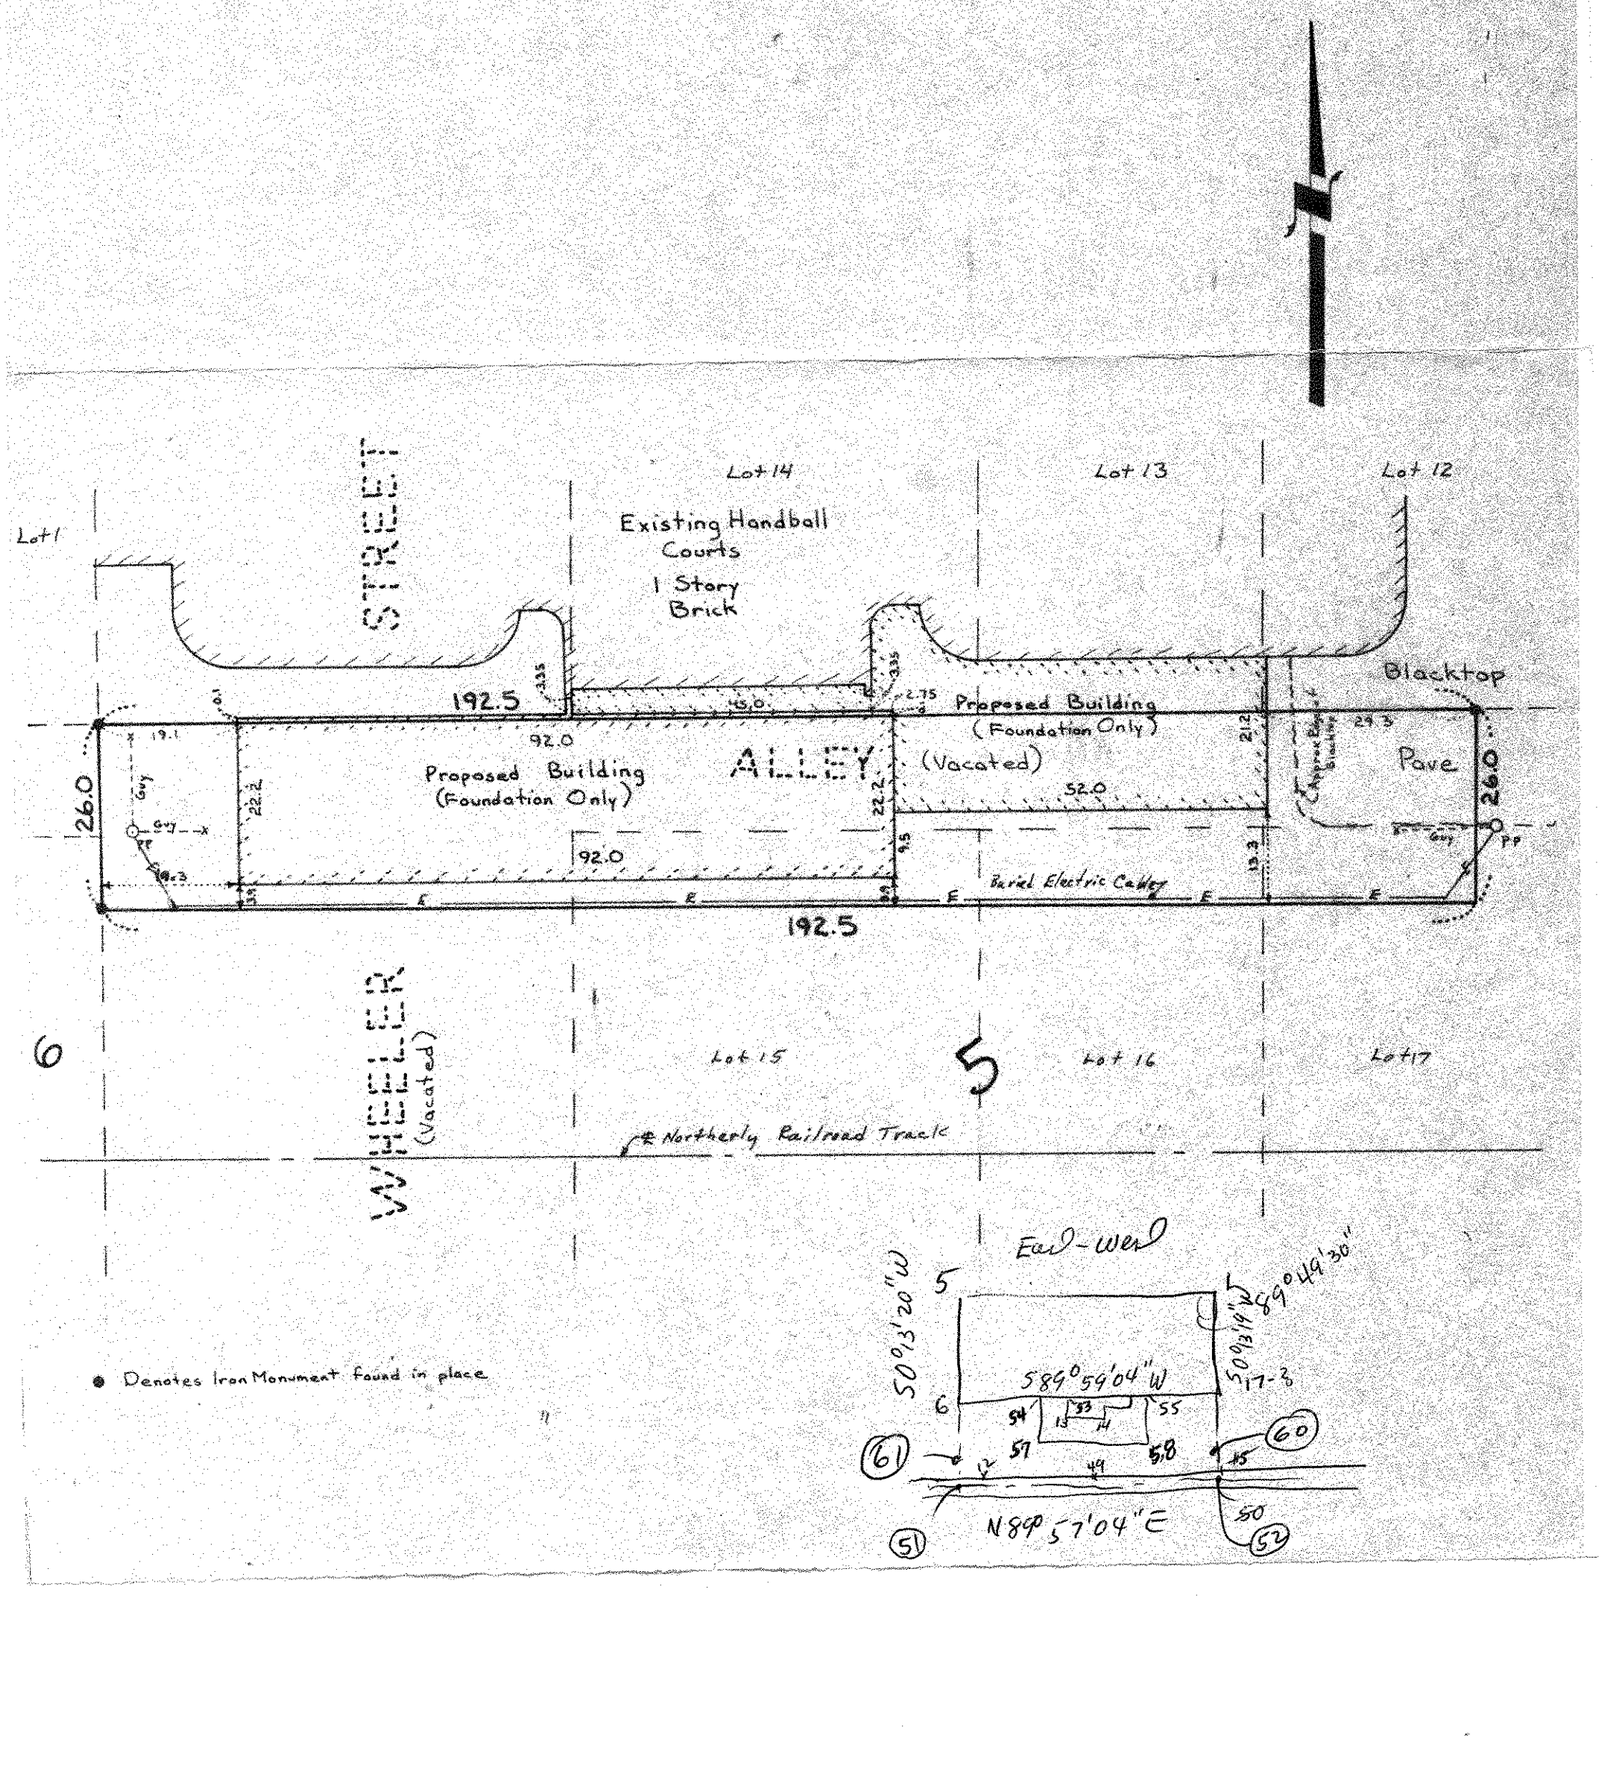
Ramsey County, Minnesota