

LOT 10 BLOCK 1  
GROVELAND PARK,

JOHN B. IRVINE, SURVEYOR.

416 GLOBE BLDG.

ST PAUL MINN.


JULY 8-1907

SCALE 20 ft. per inch

SUMMIT AVE.,

STAKE

STAKE

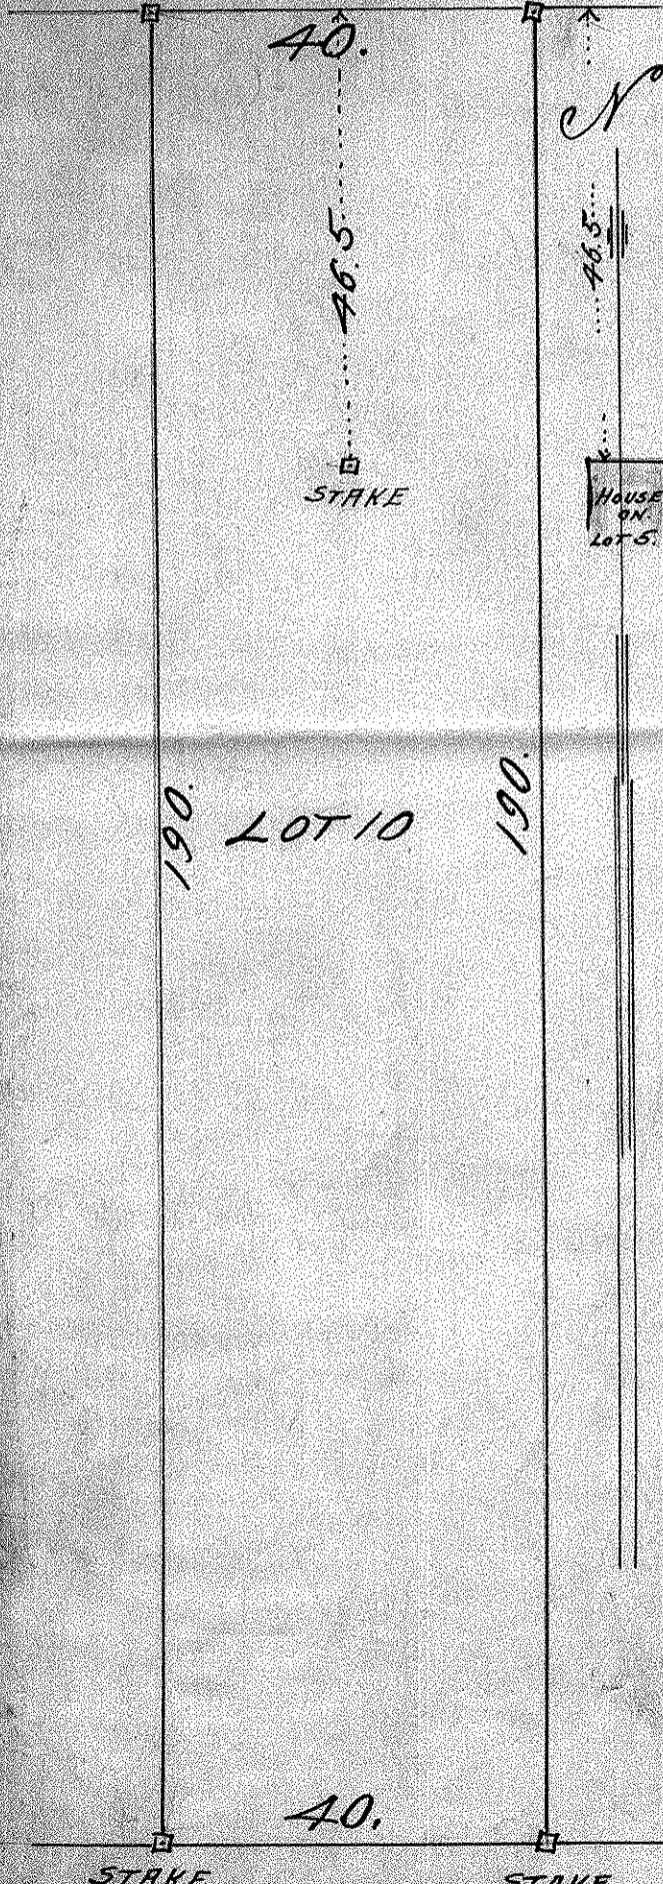

ALLEY, S.