


LOTS 5, 6, 7 & 8 BLOCK 2
GROVELAND ADD.

Oct. 2nd '03

Jas. H. Burns

Scale 20 ft = 1"

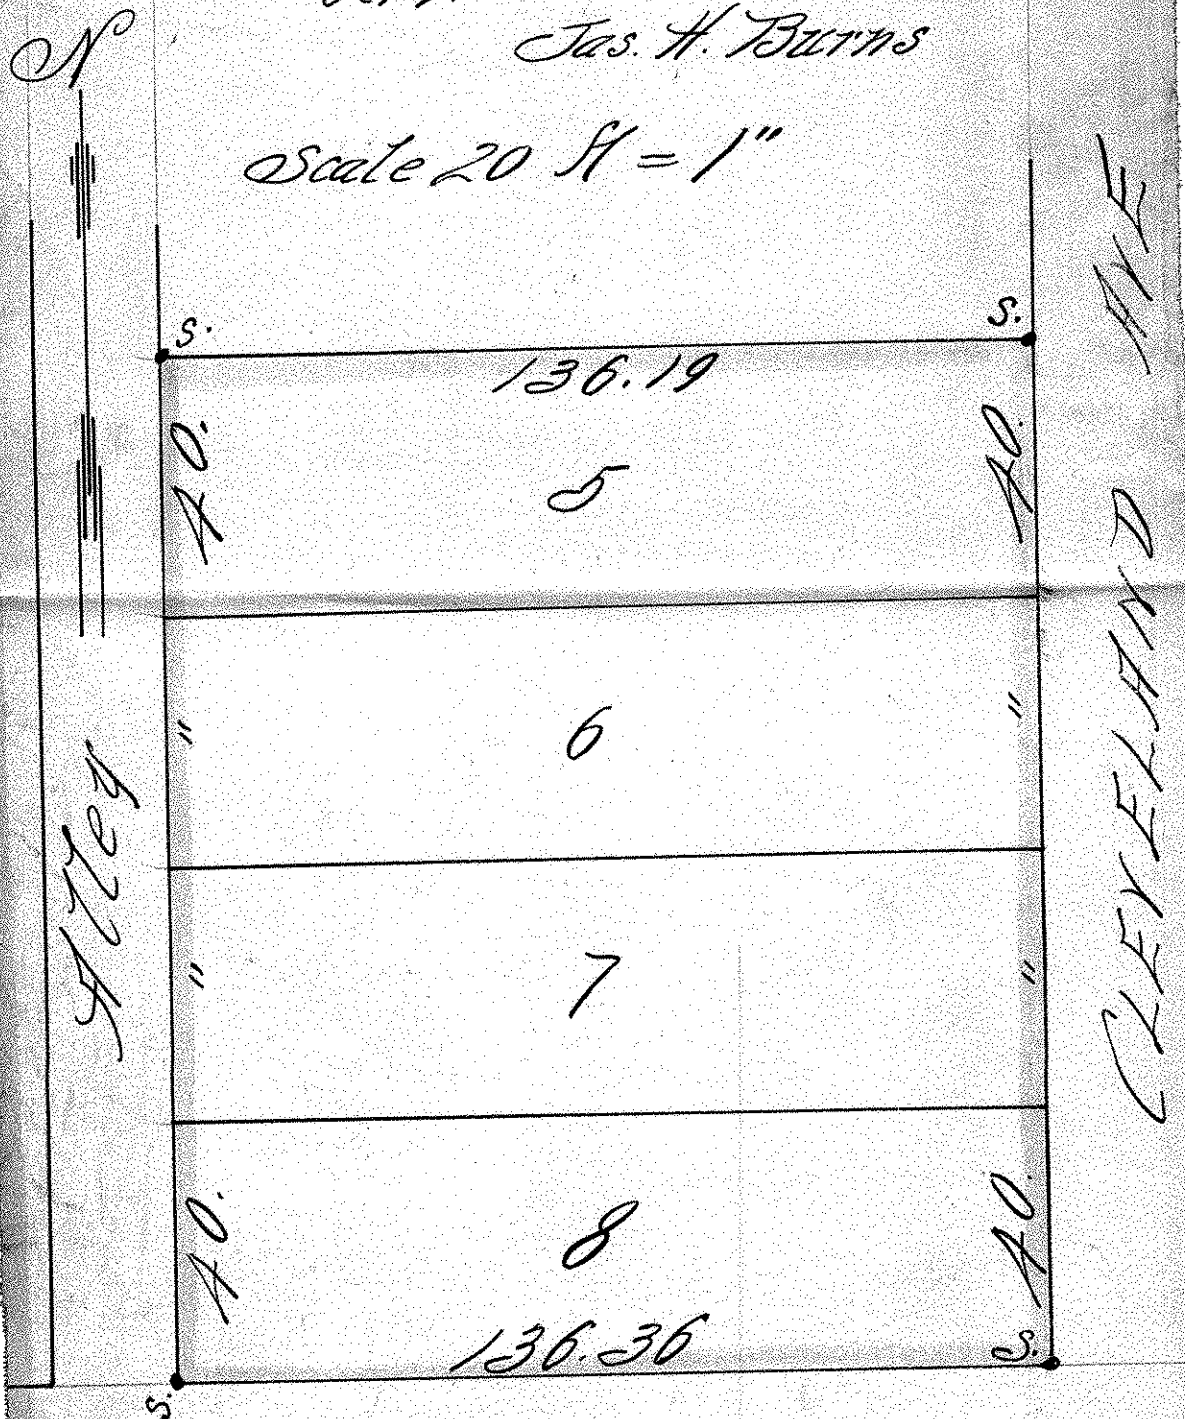

LINCOLN AVE.