NE 1 28 23

Certificate of Survey

From the office of

GEORGI- SCHMIDT & ASSOC. INC.

3092 No. Lexington Ave., Roseville, Mn. 55113
LAND SURVEYING
483-4408

I Hereby Certify that this plat shows a survey made by me of the property described on this plat, and that the corners are correctly placed as shown, and that all locations have been correctly shown.

Job Number: 462

Surveyed For Lillyholm

Date 9/6/79

Scale 1"=50'

By Donald W. Schmidt
REGISTERED LAND SURVEYOR

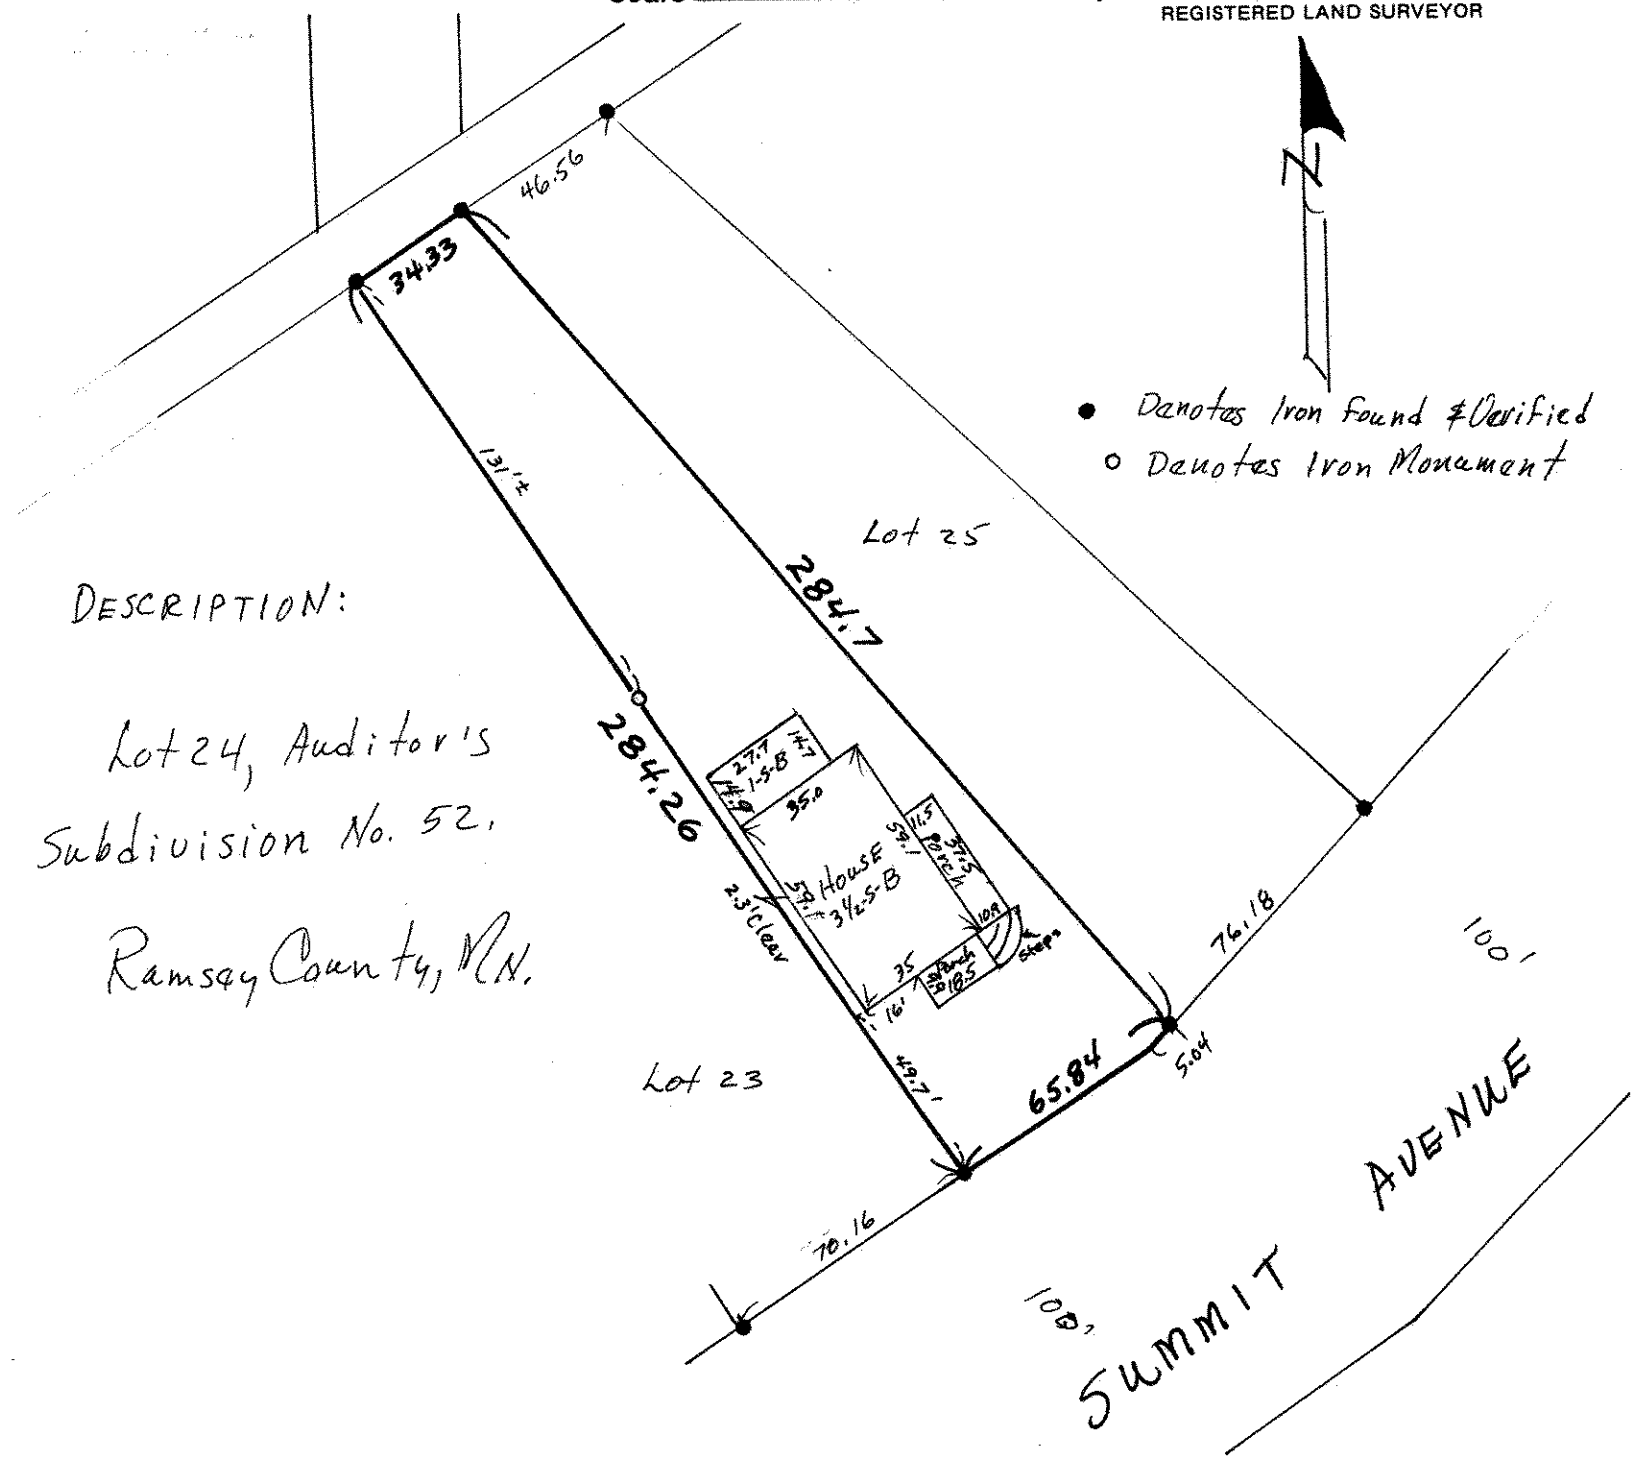

DESCRIPTION:

Lot 24, Auditor's Subdivision No. 52, Ramsey County, MN.