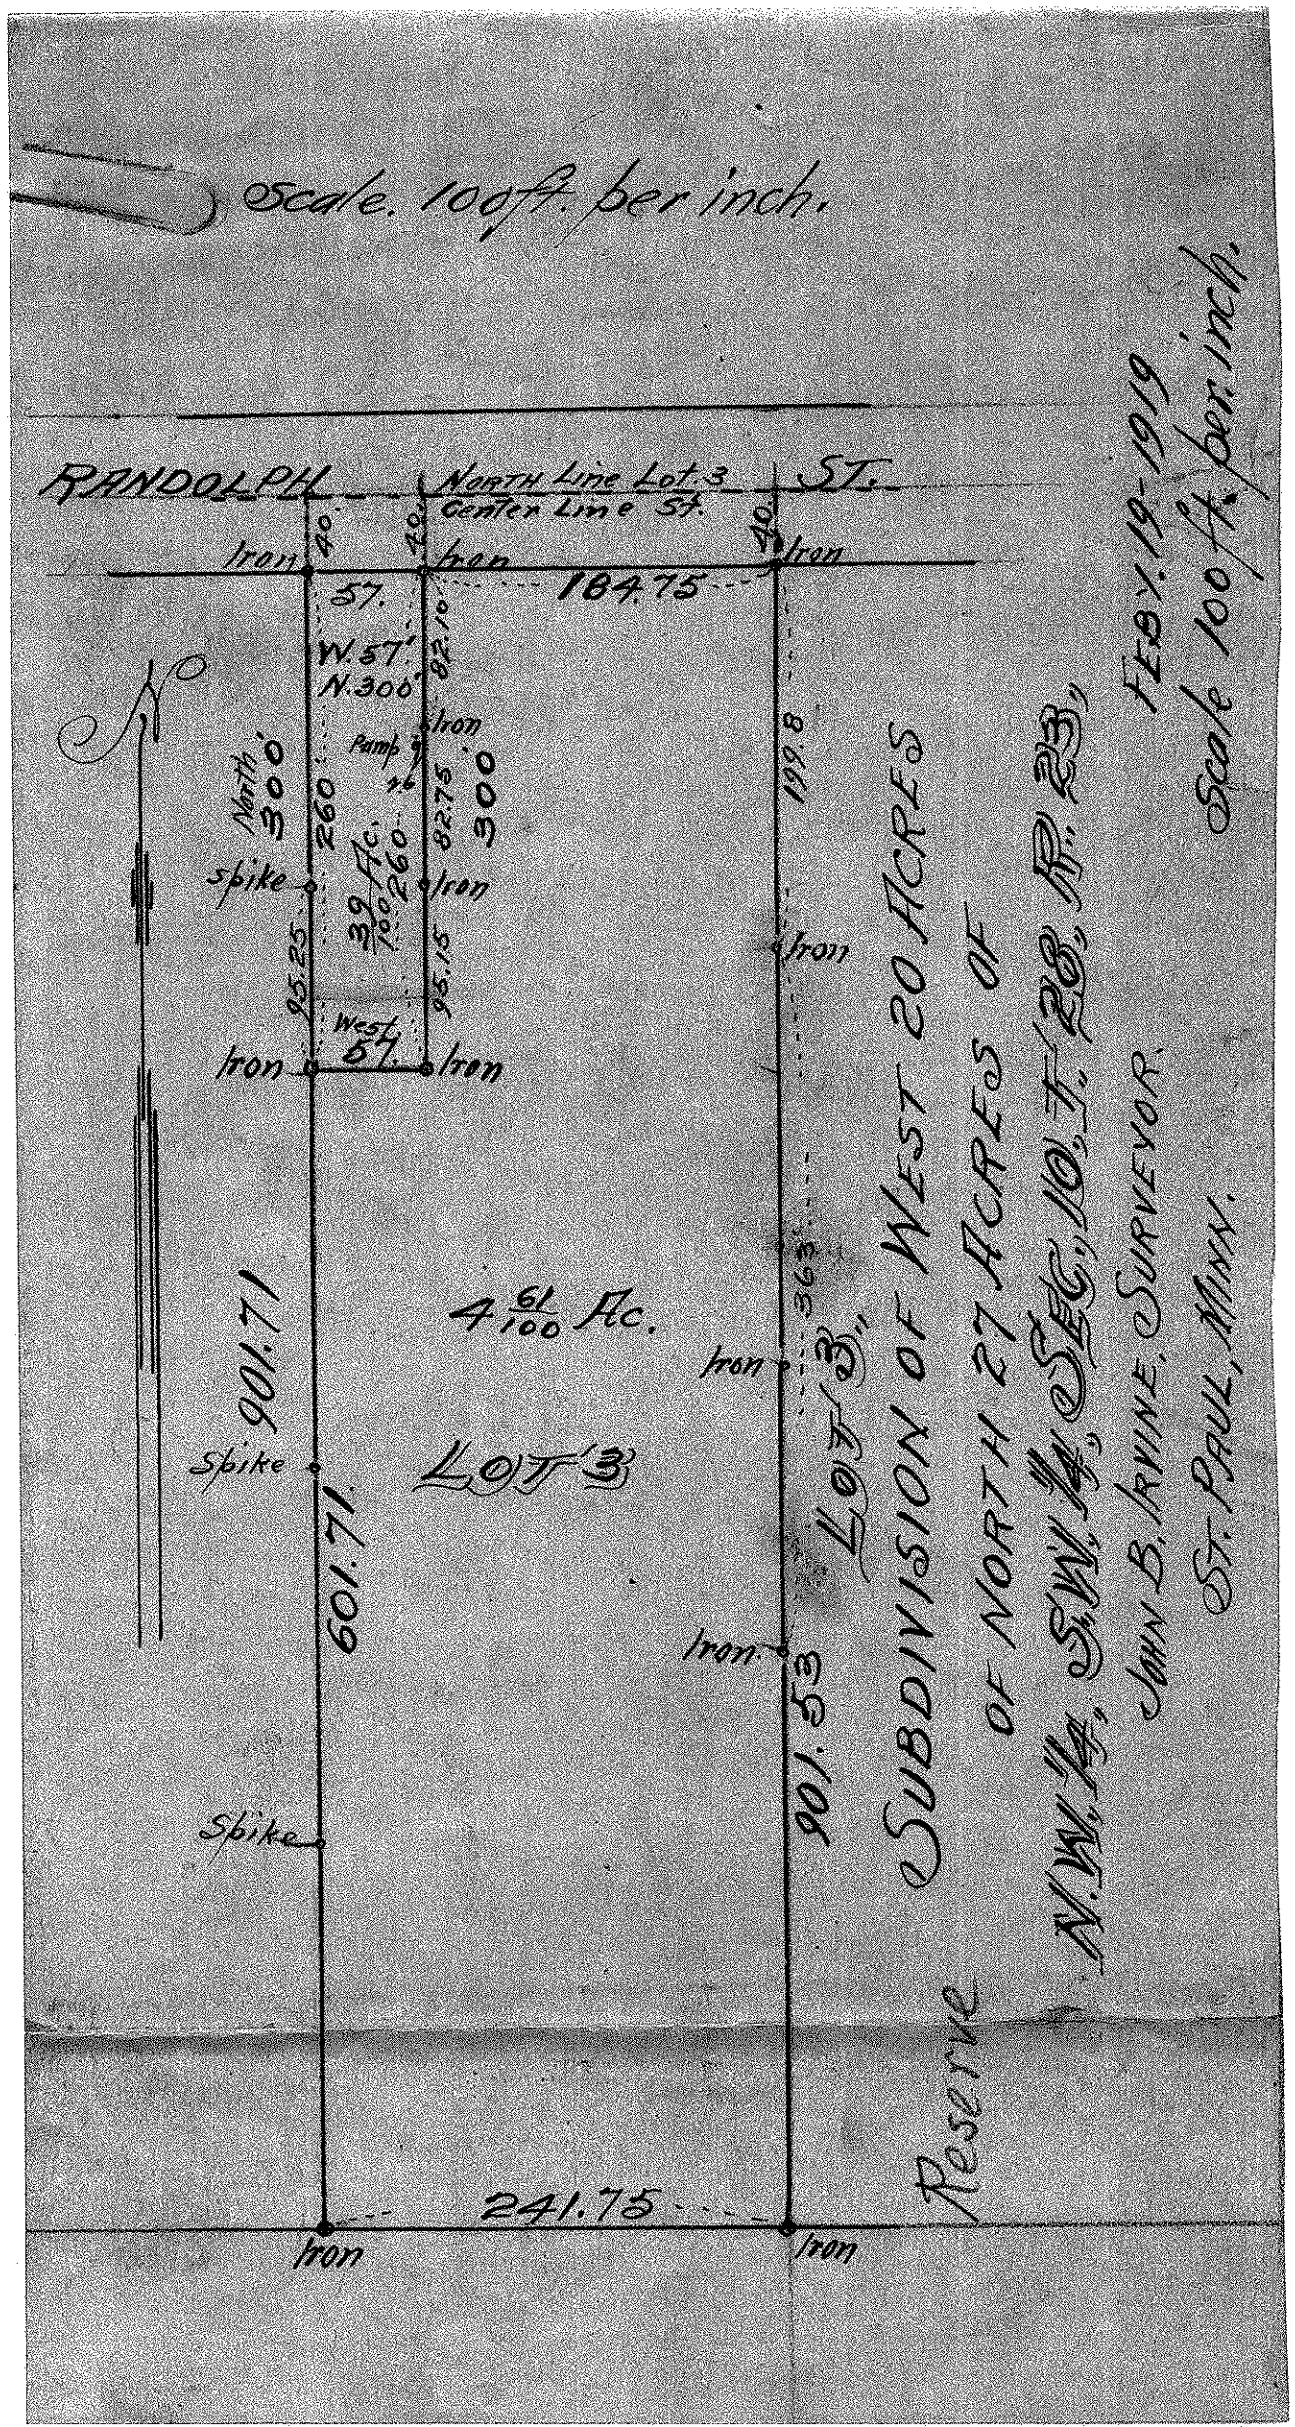
Scale. 100 ft. per inch.
RANDOLPH
North Line Lot 3
Center Line St.
ST.
Iron
40
184.75
57.
W. 57'
N. 300'
82.10
Pump
North 300'
260
82.75
300
199.8
spike
39 Ac.
100
95.25
95.15
West 57.
4 61/100 Ac.
363
901.71
Spike
LOT 3
601.71
901.53
241.75
Reserve
Lot 3.
Subdivision of West 20 Acres
of North 27 Acres of
N.W. 1/4, S.W. 1/4, Sec. 10, T. 28, R. 23,
John B. Irvine, Surveyor.
St. Paul, Minn.
Feby. 19-1919
Scale 100 ft. per inch.