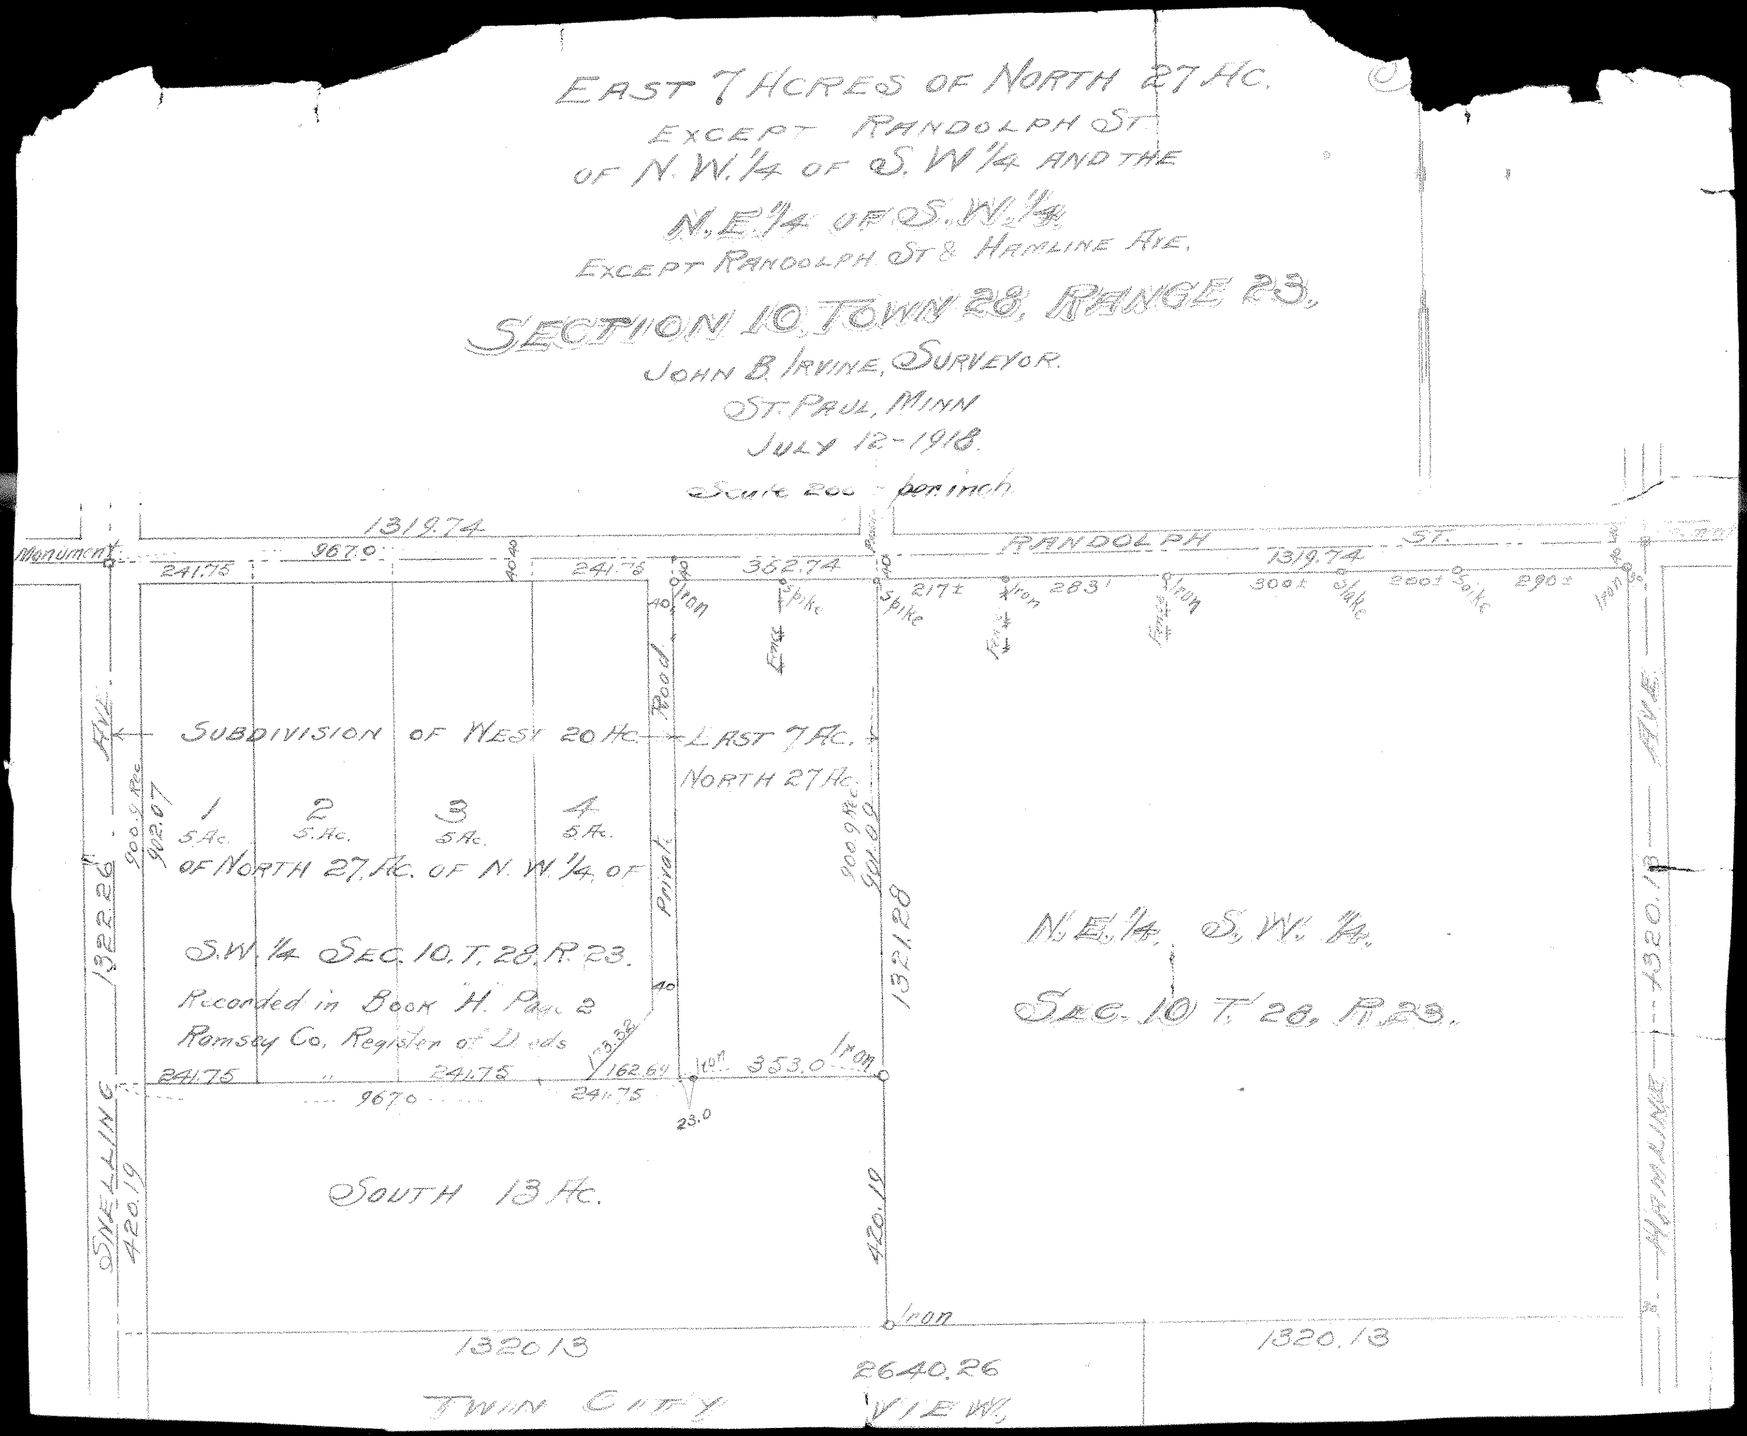
EAST 7 ACRES OF NORTH 27 AC.
EXCEPT RANDOLPH ST.
OF N.W. 1/4 OF S.W. 1/4 AND THE
N.E. 1/4 OF S.W. 1/4
EXCEPT RANDOLPH ST & HAMLINE AVE.
SECTION 10, TOWN 28, RANGE 23,
JOHN B. IRVINE, SURVEYOR.
ST. PAUL, MINN
JULY 12-1918.
Scale 200 - per inch
1319.74
Monument
967.0
241.75
352.74
RANDOLPH ST.
1319.74
217±
283'
300±
200±
290±
Iron
Spike
Fence
Road
Private
SUBDIVISION OF WEST 20 AC.
EAST 7 AC.
NORTH 27 AC.
1 5 Ac.
2 5 Ac.
3 5 Ac.
4 5 Ac.
OF NORTH 27 AC. OF N.W. 1/4 OF
S.W. 1/4 SEC. 10, T. 28, R. 23.
Recorded in Book "H" Page 2
Ramsey Co. Register of Deeds
900.9 Rec.
902.07
1322.26
1321.28
900.9 Rec.
901.09
N.E. 1/4 S.W. 1/4
SEC. 10 T. 28, R. 23.
1320.13
HAMLINE AVE.
241.75
241.75
162.69
353.0
967.0
241.75
23.0
SOUTH 13 AC.
SNELLING AVE.
420.19
420.19
1320.13
1320.13
2640.26
TWIN CITY VIEW.